THIS PERMIT VOIDS PREVIOUS ISSUED 3/10/2001

IREDELL COUNTY HEALTH DEPARTMENT

STATESVILLE 704-878-5305 MOORESVILLE 704-664-5281

IMPROVEMENT PERMIT / AUTHORIZATION TO CONSTRUCT / OPERATION PERMIT / EXISTING SYSTEM INSPECTION

PERMIT# 095049 PIN# 4703 97 2027 (PART) DATE 6-28-01

OWNER OR CONTRACTOR SOUTHERN LAND & DEV PHONE: Business Home (704) 876-1080

ADDRESS 125 GREENFIELD DRIVE WEST, STATESVILLE NC 28625

LOCATION US 70 WEST, ~ 1/2 MILE ON LEFT PAST OLD MOUNTAIN ROAD,

SUBDIVISION BLOCK / SECTION LOT LOT AREA 0.964 ACRE SITE CLASS. PS DESIGN FLOW 360 L.T.A.R. 0.35 GPD/FT²

Septic Tank: 1000 Gallons: STB 1012 Date 12-24-00 ☑ New System ☐ Repair System Type: I. II (III) IV. V. VI

Pump Tank: Gallons, PT Date System Description: 25% REDUCTION, GRAVITY

Pump Make: Model Serial No. Repair System Description: 25% REDUCTION, PUMP

Nitrification Field: No Fields 1 Square Feet EQ. TO 1035 Linear Feet ~265 Maintenance Agreement Required: ☐ Yes ☑ No

No Lines FIVE Trench Width 36" Max Trench Bottom Depth 36" Gravel Depth NA ☐ Slab ☑ Crawl Space ☐ Basement w/plumbing ☐ Basement wo/plumbing

☐ House/Mod. Home No. Bedrooms 3

☑ Mobile Home No. Bathrooms 2

☐ Business No. Employees


☐ Other

Water Supply: ☐ Individual ☑ Public ☐ Community


Comments/Conditions: INSTALL 25% REDUCTION SYSTEM USING 43 CHAMBERS (AT OWNERS REQUEST)

Comments/Conditions ① SEPTIC TANK WITH RISERS INSTALLED USING "POLYLOK" FILTER ② SYSTEM INSTALLED DURING PERIOD OF WET WEATHER

INITIAL SITE SKETCH

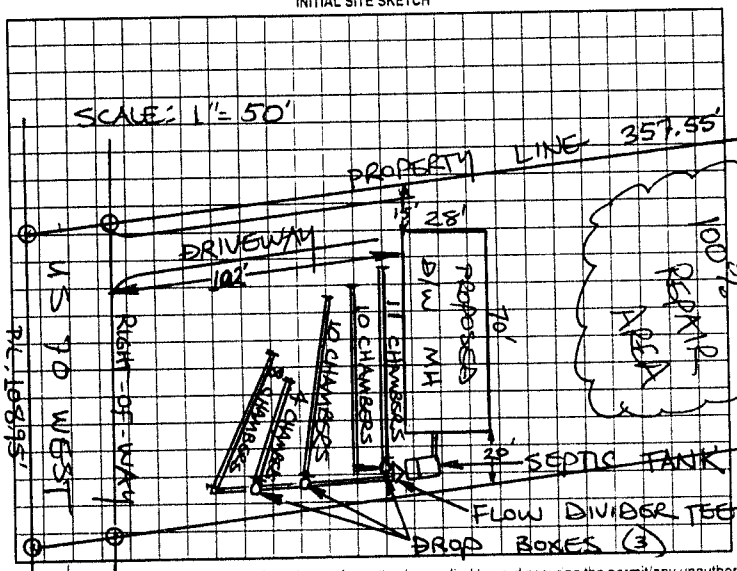

AS BUILT SKETCH

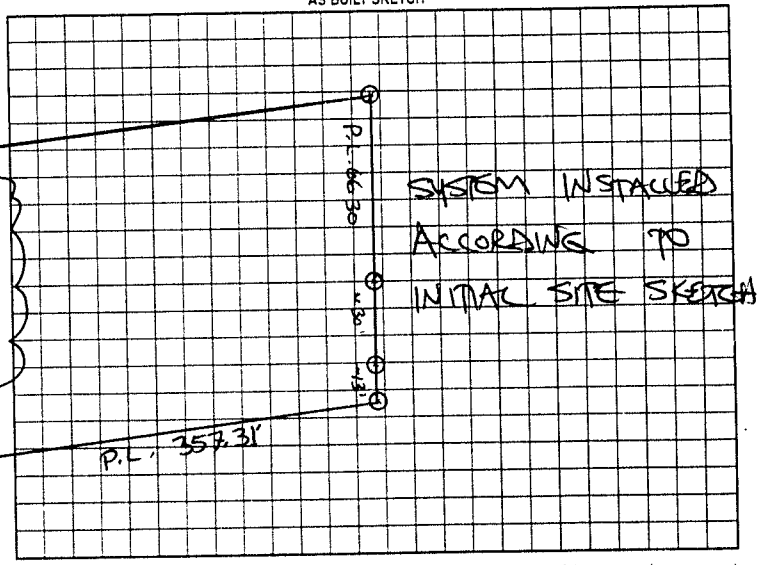

Permit can be suspended or revoked if any false information is supplied toward securing the permit/any unauthorized changes are made to the site/any unauthorized changes are made in the installation of the system. Improvement Permit with plat valid without expiration. Improvement Permit with site plan valid for sixty months. Authorization to Construct is valid for a period equal to that of Improvement Permit – not to exceed sixty months.

Signed: date 7-3-01 Installed by: FOREST STUFFORD

Improvement Permit by: STEVE HEDRICK date 6-28-01 Operation Permit by: STEVE HEDRICK date 7-17-01

Authorization to Construct by: STEVE HEDRICK date 6-28-01 Existing System Inspection by: date

HEALTH DEPT COPY: WHITE OWNER COPY (FINAL): YELLOW OWNER COPY (INITIAL): PINK