IREDELL COUNTY HEALTH DEPARTMENT

Statesville Phone TR 3-7271 Mooresville Phone NO 3-1271

PERMIT TO INSTALL SEPTIC TANK

Permit No. _____ Permit Date 10-15 1964

Owner LARRY WOOTEN Address _____

Installed By SMITH SETZER Address CATAWBA


Location of Property OFF #70 'A' PASS WHITE OAKS 1ST STREET TO LEFT 2ND BRICK ON RIGHT

Tank		Capacity		Length of Lines		Fixtures	
Block	( )	1000	( )	225'	( )	No. of Baths	( )
Precast	( )	1250	( )	250'	( )	Dishwasher	( )
		1500	( )	Other _____		Garbage Grdr.	( )
		Other _____				Other _____	

NOTIFY HEALTH DEPARTMENT AT LEAST EIGHT HOURS BEFORE TANK IS TO BE INSPECTED.

Final Inspection 10-15 1964 Approved (✓) Disapproved ( )

Remarks _____

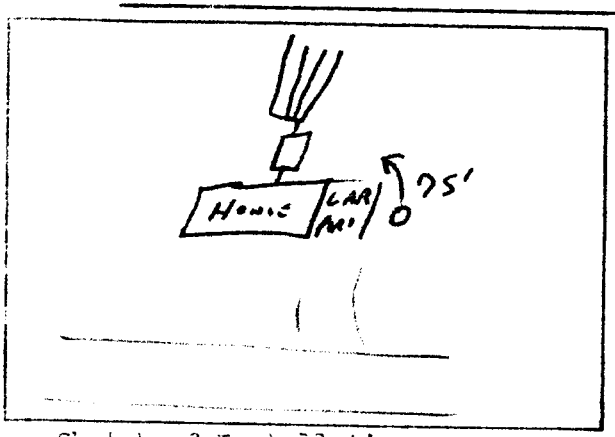

Sketch of Installation

IF NOT COVERED - 4"-8" RAIN ON 10-16-64 - TROUBLE ??

Sanitarian