IREDELL COUNTY HEALTH DEPARTMENT

Statesville Office (704) 878-5305 Mooresville Office (704) 660-3625 PERMIT # 224387

IMPROVEMENT PERMIT / AUTHORIZATION TO CONSTRUCT / OPERATION PERMIT / EXISTING SYSTEM

PIN # 4703974129

APPLICANT: Clayton Homes APPLICANT ADDRESS: 2026 Northside Dr Statesville NC

SITE ADDRESS: 112 Holman Rd Statesville NC PHONE: 704-873-2547 ALT. PHONE: 704-902-4659

SITE DIRECTIONS: 40 W T/L old Mountain Rd T/R Hwy 70 T/L Holman Rd Lot on Right

SUBDIVISION: Virgil R Elliot & Peggy Elliot SECTION: N/A LOT # 3 LOT AREA: 0.533 ac DESIGN FLOW: 360 L.T.A.R.: 0.25

Septic Tank 1000 (gal) STB 960 Date 1-22-17
Pump Tank (gal) PT Date
Pump Make Model Serial #
Nitrification Fields 1 # Lines 3 Linear Ft: 360
Trench Width 36" Max. Trench Bottom Depth 25" Gravel Depth N/A

[X] New System [ ] Repair [ ] Expansion System Type: I II [III] IV V VI
System Description: 25% Reduction
Repair System Description: Drip
Maintenance Agreement Required: [ ] YES [X] NO
[X] GRAVITY [ ] PRESSURE


[X] Residence No. Bedrooms 3
[ ] Business No. Persons 6
[ ] Other No. Employees
[ ] Slab [X] Crawl Space
[ ] Basement w/plumbing [ ] Basement w/o plumbing

Water Supply: [ ] Private [X] Public [ ] Community


Comments / Conditions: Install - 25% reduction on Contour with serial distribution Install no greater than 25" on high side

Red Filter Used ADS Chambers for Drainfield, installed as drawn.

INITIAL SITE SKETCH

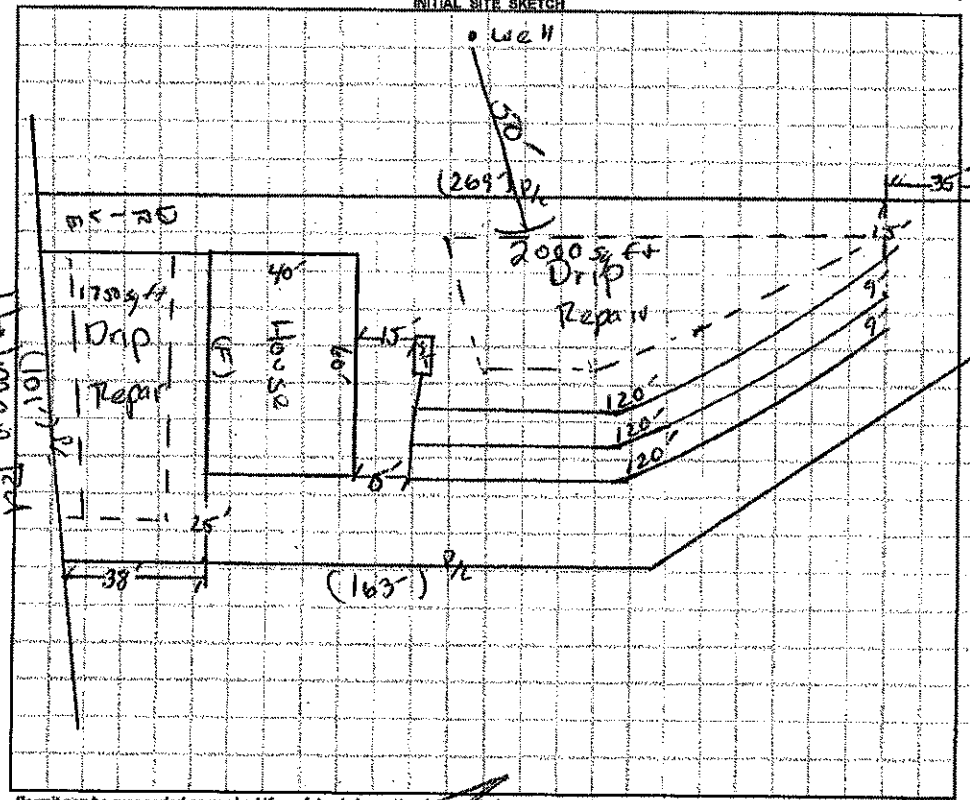

AS BUILT SKETCH

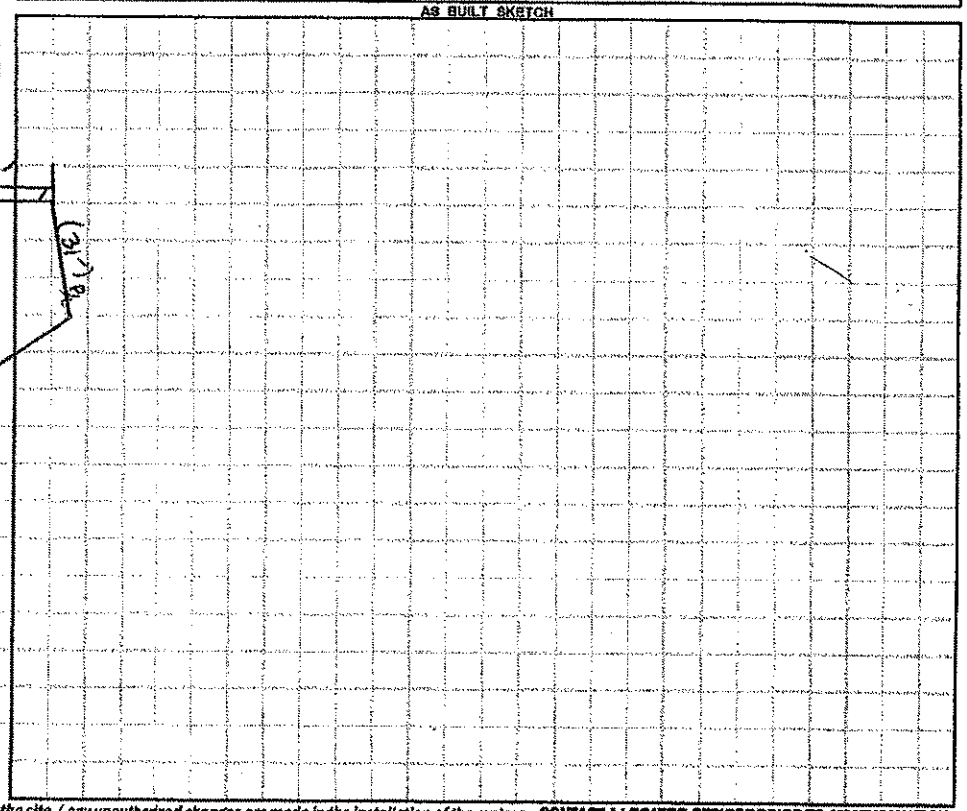

Permit can be suspended or revoked if any false information is supplied toward securing the permit / any unauthorized changes are made to the site / any unauthorized changes are made in the installation of the system. **CONTACT A LOCATOR SERVICE PRIOR TO ANY EXCAVATION**

[ ] **IMPROVEMENT PERMIT** *with plat valid without expiration.* [X] **IMPROVEMENT PERMIT** *with site plan valid for 60 mos.* [X] **AUTHORIZATION TO CONSTRUCT** *valid for period equal to IMPROVEMENT PERMIT--not to exceed 60 mo.*

Owner / Applicant Signature: Date: 2/11/17 Installed by: Abee's Grading

IMPROVEMENT PERMIT by: Date: 02/15/17 OPERATION PERMIT by: Maria Dotson Date: 4/13/17

AUTHORIZATION TO CONSTRUCT by: Date: 02/16/17 Existing System Inspected by: Date:

Health Dept. Copy - WHITE Applicant (Final Approval) - YELLOW Applicant (Conditional Approval) - PINK