IREDELL COUNTY HEALTH DEPARTMENT

Statesville Phone TR 3-7271 Mooresville Phone NO 3-1271

PERMIT TO INSTALL SEPTIC TANK

Permit NO. _____ Permit Date July 14 1959

Owner Doyle Lewan - Statesville Raleigh Address White oak

Installed By C Hoke Address R7


Location of Property Right at White oak toward Bradford X Rds. left on street 1 block out. last on left.

Tank		Capacity		Length of Lines		Fixtures	
Block	( )	800	(1)	150'	( )	No. of Baths	(1½)
Precast	(1)	900	( )	175'	( )	Dishwasher	( )
		1000	( )	200'	( )	Garbage Grdr.	( )
		1100	( )	225'	( )	Auto-Washer	( )
		1200	( )	250'	( )	Other	_____
		Other	_____	Other	165'		

NOTIFY HEALTH DEPARTMENT AT LEAST EIGHT HOURS BEFORE TANK IS TO BE INSPECTED.

Final Inspection July 14 1959 Approved ( ) Disapproved ( )

Remarks Self app. Well on pro. (owner did not cooperate on clean up of layout - (Extra deep - 100 ft)

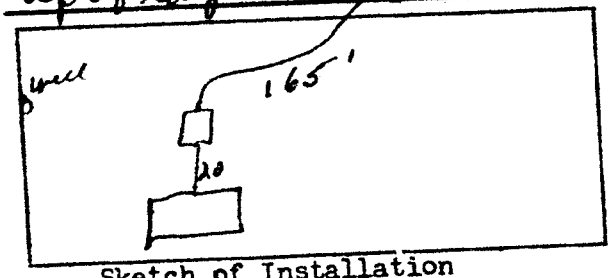

Sketch of Installation

R. G. Z

Sanitarian