IREDELL COUNTY HEALTH DEPARTMENT

STATESVILLE 704-878-5305 MOORESVILLE 704-664-5281

IMPROVEMENT PERMIT / CERTIFICATE OF COMPLETION / OPERATION PERMIT / EXISTING SYSTEM INSPECTION

PROPERTY DESCRIPTION NO. REPAIR DATE OCT 24, 1995 TAX MAP NO. Watershed: ☐ Yes ☑ No

OWNER OR CONTRACTOR JOHN FORSYTH PHONE: Business Home 872-1848

ADDRESS 1777 OLD MOUNTAIN ROAD, STATESVILLE NC 28677

LOCATION I-40 W, TL OLD MOUNTAIN RD ON (R), JUST PAST ENGINE ROAD AT BOX #1777

SUBDIVISION BLOCK / SECTION LOT LOT AREA AMPLE SITE CLASS. PS DESIGN FLOW 360 L.T.A.R. EXISTING

Septic Tank: EXISTING Gallons; STB Date

Pump Tank: Gallons; PT Date

Pump Make: Model Serial No.

Nitrification Field: No Fields 1 Square Feet 330 Linear Feet 110

No Lines 1 Trench Width 36" Max Trench Bottom Depth ~36" Gravel Depth (24")

☐ New System ☑ Repair System Type: I, (II), III, IV, V, VI

System Description: CONVENTIONAL GRAVITY

Repair System Description: CONV. GRAVITY

Maintenance Agreement Required: ☐ Yes ☑ No

☑ House/Mod. Home No. Bedrooms 3

☐ Mobile Home No. Bathrooms 1

☐ Business No. Employees

☐ Other


☐ Slab ☑ Crawl Space ☐ Basement w/plumbing ☐ Basement wo/plumbing

Water Supply: ☑ Individual ☐ Community ☑ Public

Comments: (1) REPLACE SANITARY TEE IN SEPTIC TANK IF NECESSARY (2) INSTALL NEW DISTRIBUTION BOX AS SHOWN (3) INSTALL NEW 3'X 110' LINE USING 24" STONE

Comments:

INITIAL SITE SKETCH

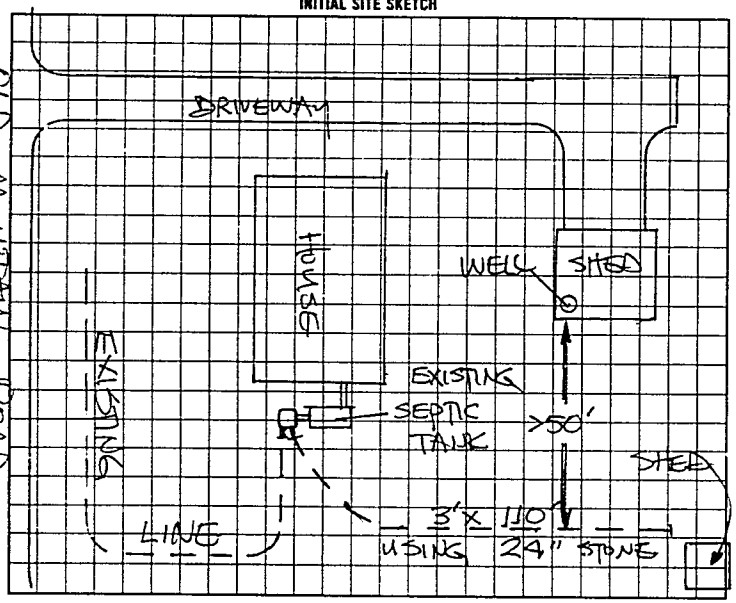

AS BUILT SKETCH

SYSTEM REPAIRED ACCORDING TO INITIAL SITE SKETCH

I understand that this permit can be suspended or revoked if any false information is supplied toward securing the permit/any unauthorized changes are made to the site/any unauthorized changes are made in the installation of the system.

AUTHORIZATION TO CONSTRUCT IS VALID FIVE (5) YEARS FROM DATE OF ISSUANCE. IMPROVEMENT PERMIT HAS NO EXPIRATION DATE.

Signed: X [signature] Forsyth

Improvement Permit by: STEVE HEDRICK date 10/24/95

Authorization to Construct by: STEVE HEDRICK date 10/24/95

Existing System Inspection by:

Installed by: JAMES HUDLER

Certificate of Completion by: date

Operation Permit by: STEVE HEDRICK date 10-27-95

HEALTH DEPT. COPY: WHITE INSPECTION COPY (FINAL): GREEN OWNER COPY (FINAL): YELLOW INSPECTION COPY (INITIAL): PINK OWNER COPY (INITIAL): GOLD

000231