Authorization To Construct

4:00 Steve Jordan

IREDELL COUNTY HEALTH DEPARTMENT

STATESVILLE 704-878-5305 MOORESVILLE 704-664-5281

IMPROVEMENT PERMIT / ~~CERTIFICATE OF COMPLETION~~ / OPERATION PERMIT / EXISTING SYSTEM INSPECTION

PROPERTY DESCRIPTION NO 23849 DATE 6/10/96 TAX MAP NO 8N-A-88 Watershed: ☐ Yes ☒ No

OWNER OR CONTRACTOR Terry L. Cline PHONE: Business 662-9642 Home

ADDRESS PO Box 5633 Statesville NC

LOCATION I-40 W, R on Old Mountain, LF on Island Ford, LF on Cullen At End, MH is 0.5 miles LF at end of Cullen

SUBDIVISION BLOCK / SECTION LOT LOT AREA 11.66 acres SITE CLASS. 2A DESIGN FLOW 240gpd L.T.A.R. 0.3 gpd/ft²

Septic Tank: 1000 Gallons: STB 3/29/96 STB1012 18

Pump Tank: Gallons: PT Date

Pump Make: Model Serial No

Nitrification Field: No Fields 1 Square Feet 810 Linear Feet 270

No Lines 2 Trench Width 36 Max Trench Bottom Depth 36 Gravel Depth 12"

☒ New System ☐ Repair System Type: I II III IV V VI

System Description: Conventional Grouty

Repair System Description: Conventional Grouty

Maintenance Agreement Required Yes ☒ No

☒ House/Mod Home No Bedrooms 3

☒ Mobile Home No. Bathrooms 2

☐ Business No. Employees

Other Future House


Slab ☒ Crawl Space Basement w/plumbing Basement w/o plumbing

Water Supply: ☒ Individual ☐ Community ☐ Public TO Be Drilled


Comments: System sized to accomodate future two bedroom house MH will be poked off of that trunk

Comments: Upper line fed slightly first w/ Speed Leveler.

INITIAL SITE SKETCH

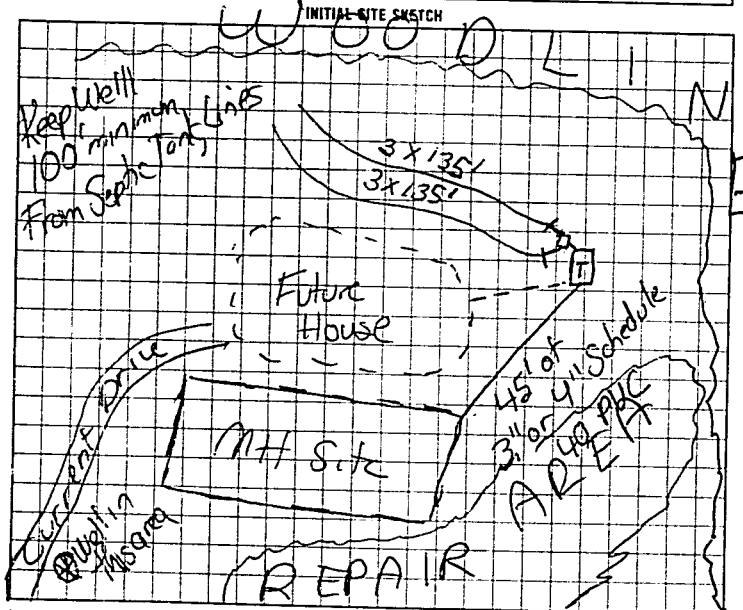

AS BUILT SKETCH

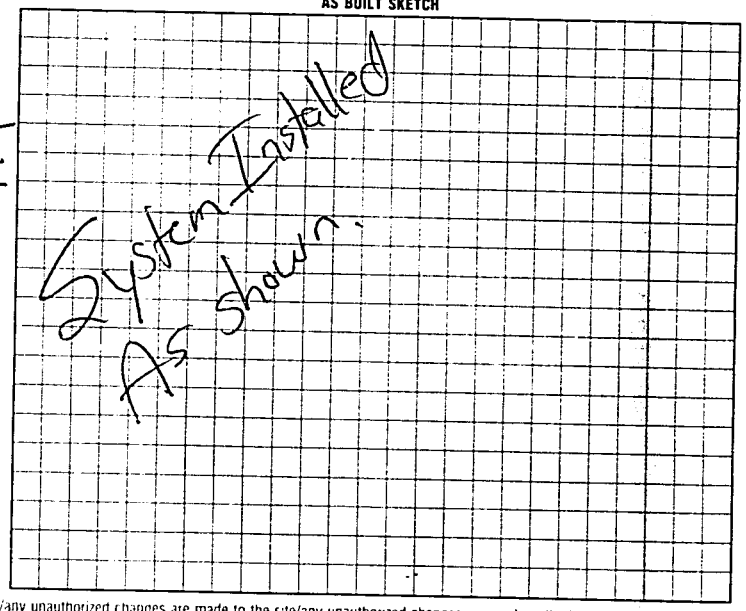

I understand that this permit can be suspended or revoked if any false information is supplied toward securing the permit/any unauthorized changes are made to the site/any unauthorized changes are made in the installation of the system

Signed Terry L Cline

Improvement Permit by date 6/10/96

~~Existing System Inspection by~~ date 6/10/96

Authorization To Construct By

INSPECTION COPY (FINAL) GREEN OWNER COPY (FINAL) YELLOW

Installed by Steve Jordan

Certificate of Completion by date

Operation Permit by date 6/14/96

INSPECTION COPY (INITIAL) PINK