IREDELL COUNTY HEALTH DEPARTMENT

STATESVILLE 704-878-5305 MOORESVILLE 704-664-5281

IMPROVEMENT PERMIT / CERTIFICATE OF COMPLETION / OPERATION PERMIT / EXISTING SYSTEM INSPECTION

Lot 21 on Terminal

PROPERTY DESCRIPTION NO. 18377 DATE 9-30-94 TAX MAP NO. 8M-6-A-4 Watershed: ☐ Yes ☑ No

OWNER OR CONTRACTOR Jack Clanton PHONE: Business _____ Home 872-0227

ADDRESS P.O. Box 1651 Statesville, N.C 28677

LOCATION I40W TL Old Mtn. Rd TR Beulah Rd Stay Straight Mock Mill Rd [redacted] 2nd lot on L past Mill Pond Rd.

SUBDIVISION Mock Mill Run BLOCK / SECTION _____ LOT 4 LOT AREA _____ SITE CLASS. P.S. DESIGN FLOW 240 L.T.A.R. .25 grd 1ft²

Septic Tank: 1000 Gallons; STB 1012 Date 8-8-94
Pump Tank: — Gallons; PT — Date —
Pump Make: — Model — Serial No. —
Nitrification Field: No Fields 1 Square Feet 960 Linear Feet 320'
No Lines 2 Trench Width 36" Max Trench Bottom Depth 24" Gravel Depth 12"

☑ New System ☐ Repair System Type: I, II, III, IV, V, VI
System Description: conventional, gravity fed
Repair System Description: pump to conventional
Maintenance Agreement Required: ☐ Yes ☑ No

☐ House/Mod. Home ☑ Mobile Home ☐ Business ☐ Other
No. Bedrooms 2 No. Bathrooms 2 No. Employees ____


☐ Slab ☑ Crawl Space ☐ Basement w/plumbing ☐ Basement wo/plumbing

Water Supply: ☐ Individual ☐ Community ☑ Public


Comments: INSTALL SYSTEM SHALLOW (no deeper than 24" to trench bottom) Keep lines and trenches on contour. Keep system min 5' from foundation of home, 10' from all water lines, and 20' from any existing system. 100% Repair in front yard, pump to conventional.

Comments: Had to install step down in lower line due to the line having too much fall, 6". Step down install approx. 50' from box. Due to step down, a speed leveler was place in that line to feed last. Home not located at time of inspection. Keep home min. 5' from any part of septic system.

INITIAL SITE SKETCH

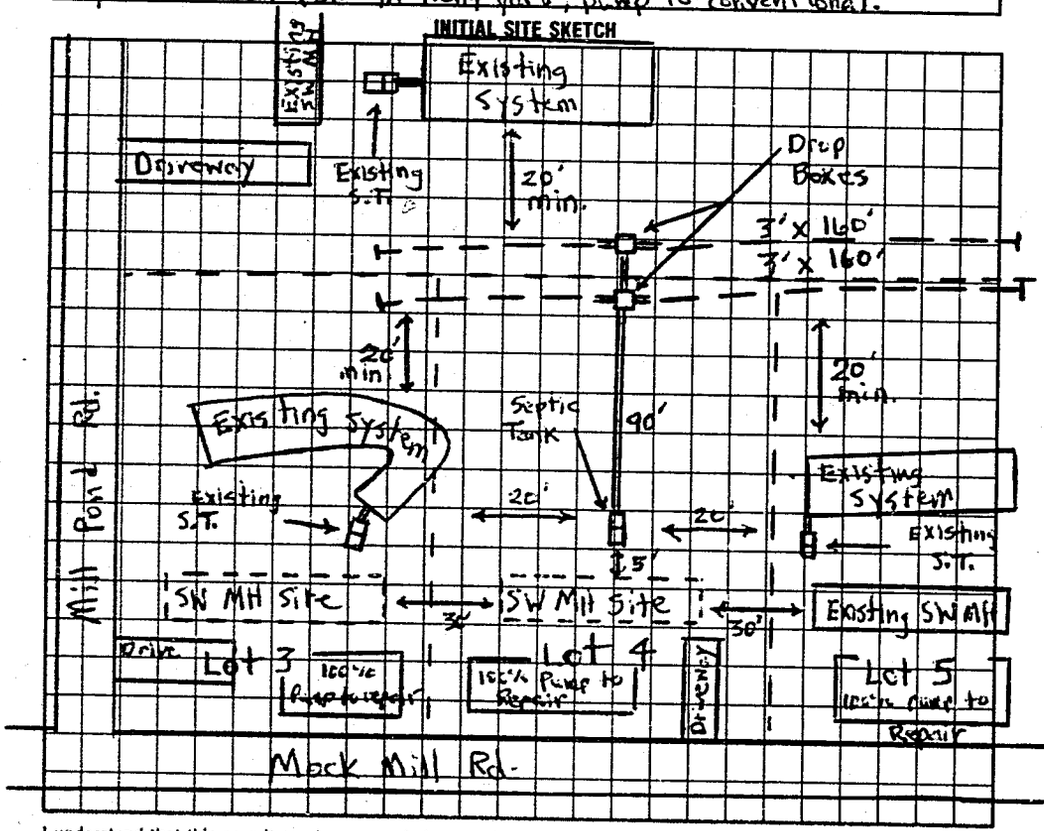

AS BUILT SKETCH

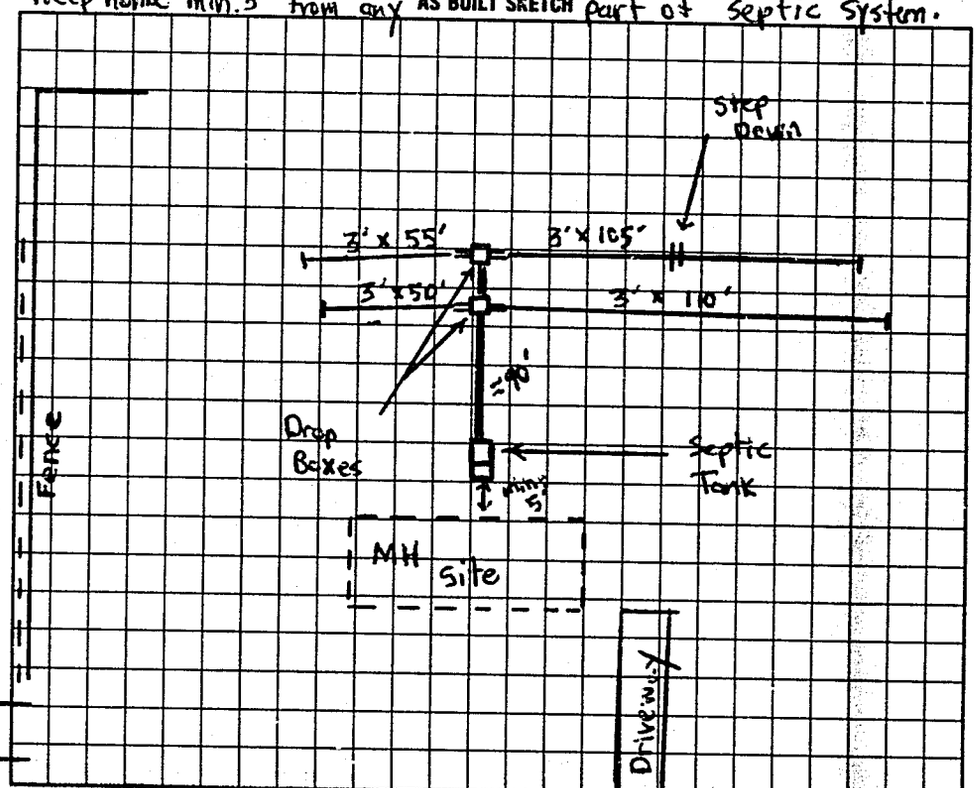

I understand that this permit can be suspended or revoked if any false information is supplied toward securing the permit/any unauthorized changes are made to the site/any unauthorized changes are made in the installation of the system. Improvement Permit is valid for 60 months from date of issuance.

Signed: Jack Clanton

Improvement Permit by: Michael L. Dennis / J.C. Moore date 9-30-94

Existing System Inspection by: _____ date _____

Installed by: North Iredell Backhoe Service

Certificate of Completion by: Michael L. Dennis date 10-19-94

Operation Permit by: _____ date _____

HEALTH DEPT COPY WHITE INSPECTION COPY (FINAL) GREEN OWNER COPY (FINAL) YELLOW INSPECTION COPY (INITIAL) PINK OWNER COPY (INITIAL) GOLD