IREDELL COUNTY HEALTH DEPARTMENT

STATESVILLE 704-878-5305 MOORESVILLE 704-664-5281

IMPROVEMENT PERMIT / AUTHORIZATION TO CONSTRUCT / OPERATION PERMIT / EXISTING SYSTEM INSPECTION

PERMIT# REPAIR PIN# 4704-30-9314 DATE 10-29-04

OWNER OR CONTRACTOR JIM L. WOOTEN PHONE: Business 704-873-1990 Home

ADDRESS 2262 OLD WILKESBORO ROAD STATESVILLE NC 28625-9332

LOCATION I-40 W, TL OLD MTN. RD, TR BEULAH RD, CONTINUE MOCK MILL RD, TL HUNTERPOND LN, 1ST ON RIGHT

SUBDIVISION _____ BLOCK / SECTION _____ LOT _____ LOT AREA 0.5 ACRE SITE CLASS. PS DESIGN FLOW 240 L.T.A.R. EXISTING 0.8

Septic Tank: EXISTING Gallons: STB _____ Date _____

Pump Tank: _____ Gallons: PT _____ Date _____

Pump Make: _____ Model _____ Serial No. _____

Nitrification Field: No Fields 1 Square Feet 540 Linear Feet 180

No Lines TWO Trench Width 36" Max Trench Bottom Depth 36" Gravel Depth 12"

☐ New System ☑ Repair System Type: I, II, III, IV, V, VI

System Description: CONVENTIONAL, GRAVITY

Repair System Description: CONVENTIONAL, GRAVITY

Maintenance Agreement Required: ☐ Yes ☑ No

☐ House/Mod. Home ☑ Mobile Home ☐ Business ☐ Other

No. Bedrooms 2 No. Bathrooms 2 No. Employees ____


☐ Slab ☑ Crawl Space ☐ Basement w/plumbing ☐ Basement wo/plumbing

Water Supply: ☐ Individual ☑ Public ☐ Community


Comments:/Conditions: INTERSECT EXISTING DRAINLINE WITH NEW DROP BOX AS SHOWN, SERIALLY FEED TWO NEW DRAIN LINES. THIS PERMIT SERVES AS "NOTICE OF VIOLATION" TO BE REPAIRED BY NOV 29, 04

Comments:/Conditions:

INITIAL SITE SKETCH

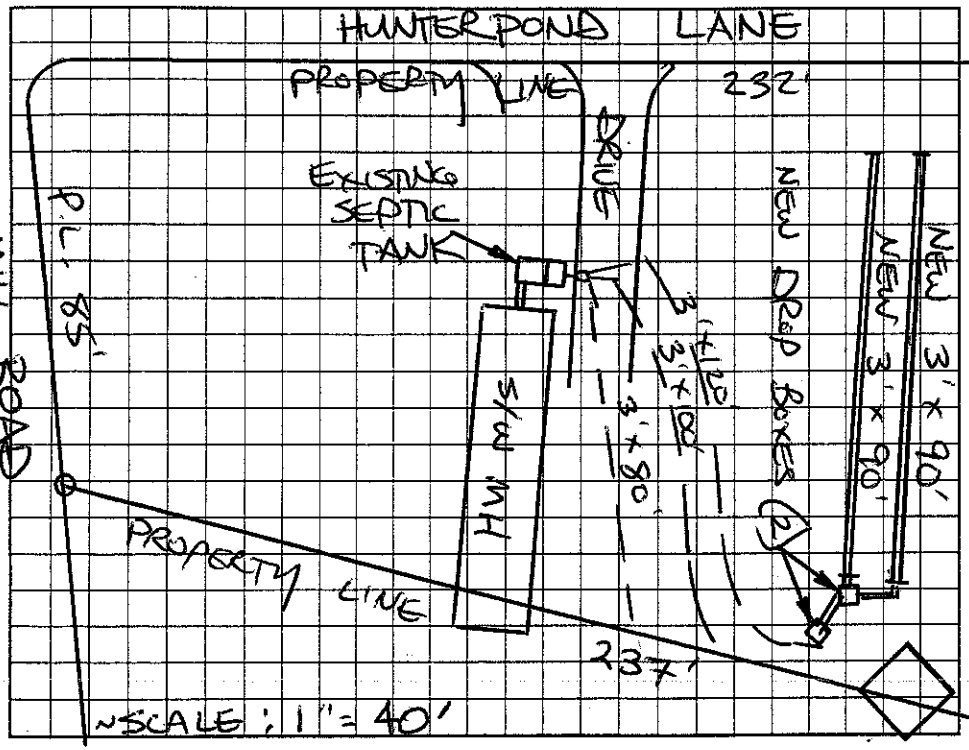

AS BUILT SKETCH

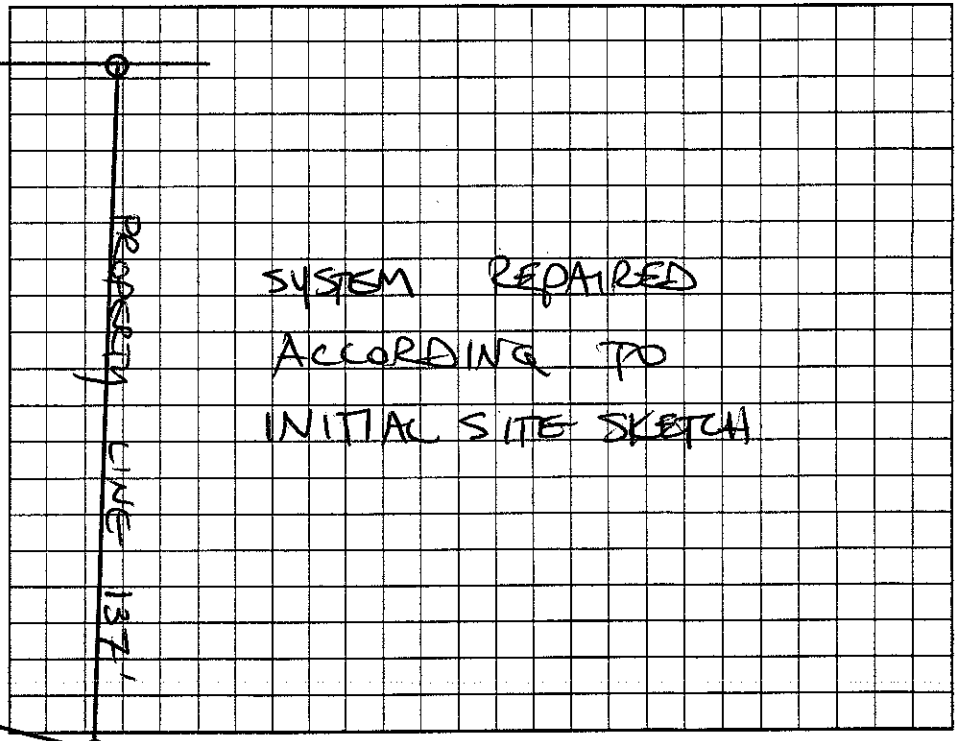

Permit can be suspended or revoked if any false information is supplied toward securing the permit/any unauthorized changes are made to the site/any unauthorized changes are made in the installation of the system. Improvement Permit with plat valid without expiration. Improvement Permit with site plan valid for sixty months. Authorization to Construct is valid for a period equal to that of Improvement Permit – not to exceed sixty months.

Signed: Jim Wooten date 10-29-04

Improvement Permit by: STEVE HEDRICK date 10-29-04

Authorization to Construct by: STEVE HEDRICK date 10-29-04

Installed by: JAMES HUDLER

Operation Permit by: STEVE HEDRICK date 11-3-04

Existing System Inspection by: _____ date _____

HEALTH DEPT. COPY: WHITE OWNER COPY (FINAL): YELLOW OWNER COPY (INITIAL): PINK