IREDELL COUNTY HEALTH DEPARTMENT - *ENVIRONMENTAL HEALTH* ☒ STATESVILLE OFFICE 704-878-5305 ☐ MOORESVILLE OFFICE 704-664-5281

IMPROVEMENT PERMIT / AUTHORIZATION TO CONSTRUCT / OPERATION PERMIT / EXISTING SYSTEM INSPECTION

PERMIT # 169872 PIN # 4704-31-4991 DATE 1-13-12

OWNER Michael A. Dea APPLICANT: SAME PHONE: Home/Cell # 704-902-4262 Business #

SITE ADDRESS 155 Hog Jaw OWNER / APPLICANT ADDRESS

SITE DIRECTIONS 40W (L) on Old Mtn Rd (R) Beulah Church Rd; go 1 mi, 3rd rd - Hog Jaw - house at end.

SUBDIVISION n/a BLOCK / SECTION n/a LOT # n/a LOT AREA 4.52 DESIGN FLOW 100 L.T.A.R. .3

Septic Tank 1000 Gallons: STB 794 Date 2-19-12 ☒ New System ☐ Repair ☐ Expansion System Type I II (III) IV V VI

Pump Tank Gallons: PT Date System Description: 25% Reduction - Gravity

Pump Make Model Serial # Repair System Description: 25% Reduction

No. Nitrification Fields: 1 No. Lines 2 Linear Feet 84 total Maintenance Agreement Required ☐ YES ☒ NO


Trench Width 36" Max. Trench Bottom Depth 36" Gravel Depth n/a ☒ GRAVITY ☐ PRESSURE

☒ Residence No. Bedrooms 3 ☐ Business No. Persons ☐ Other No. Employees ☒ Slab ☐ Crawl Space ☐ Basement w/plumbing ☐ Basement w/o plumbing


Water Supply: ☒ Private ☐ Public ☐ Community

Comments / Conditions

INITIAL SITE SKETCH

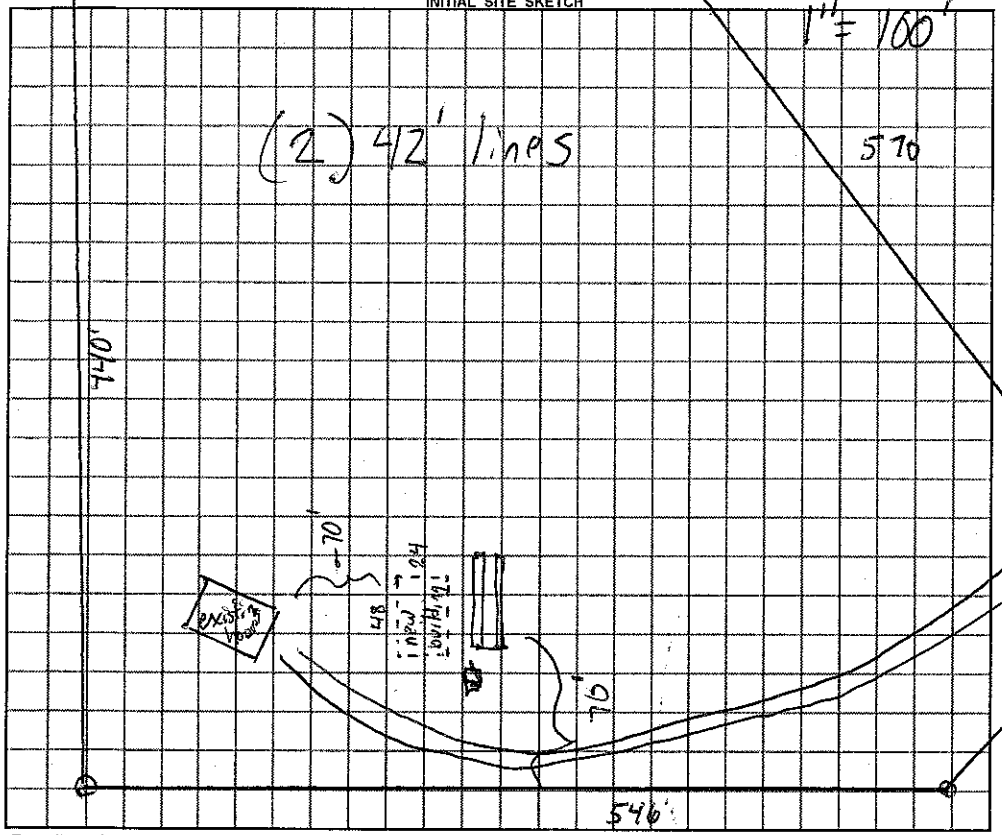

AS BUILT SKETCH

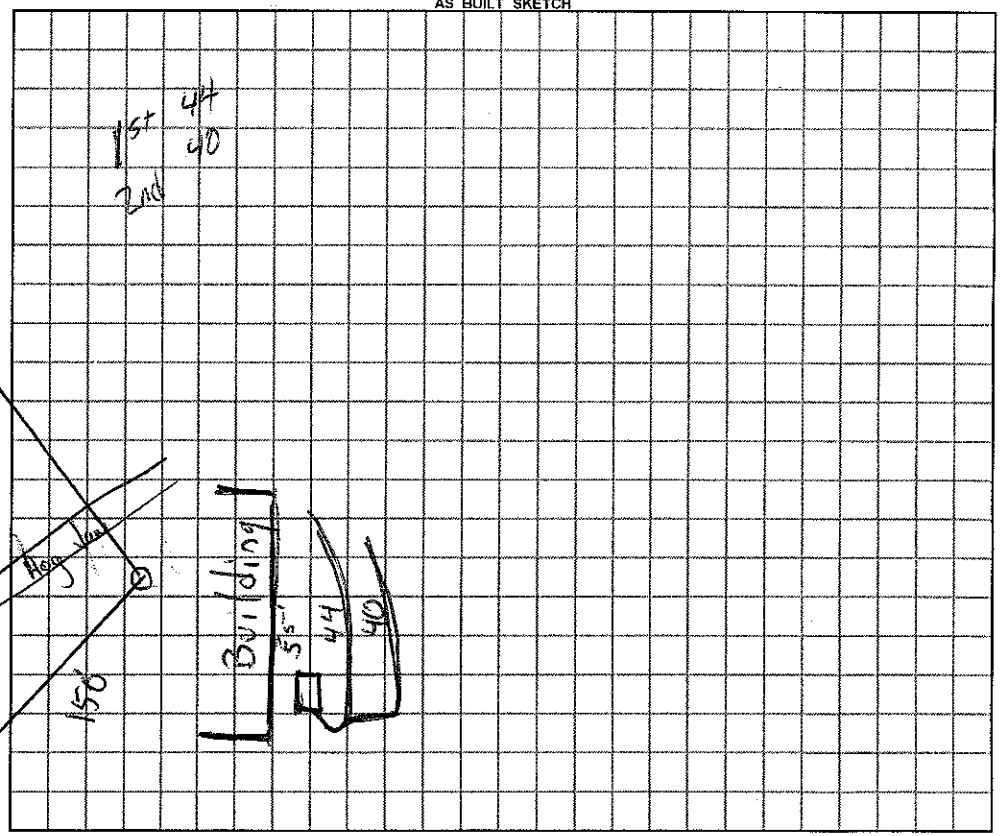

Permit can be suspended or revoked if any false information is supplied toward securing the permit / any unauthorized changes are made to the site / any unauthorized changes are made in the installation of the system.

☐ *IMPROVEMENT PERMIT* with plat valid without expiration. ☒ *IMPROVEMENT PERMIT* with plat valid without expiration. site plan valid 60 mo. ☒ *AUTHORIZATION TO CONSTRUCT* valid for period equal to IMPROVEMENT PERMIT--not to exceed 60 mo.

Owner / Applicant Signature: Michael A Dea Date 1-13-12 Installed by: Huddle

IMPROVEMENT PERMIT by: REHS Date 1-13-12 OPERATION PERMIT by: REHS Date 4-25-12

AUTHORIZATION TO CONSTRUCT by: REHS Date 1-13-12 Existing System Inspected by: REHS Date

YOU SHOULD CONTACT A LOCATOR SERVICE PRIOR TO ANY EXCAVATION

White Copy – Environmental Health YELLOW COPY (Final) Owner / Applicant PINK COPY (Initial) Owner / Applicant