IREDELL COUNTY HEALTH DEPARTMENT

STATESVILLE 704-878-5305 MOORESVILLE 704-664-5281

IMPROVEMENT PERMIT / AUTHORIZATION TO CONSTRUCT / OPERATION PERMIT / EXISTING SYSTEM INSPECTION

PERMIT# 149097 PIN# 4704320912 DATE 3-20-08

OWNER OR APPLICANT Clayton Homes (Jerry Mayberry) PHONE: Business 704 873 2547 Home

ADDRESS 423 Beulah Rd

LOCATION 140(W) to exit 144 to Old Mtn. Rd (L) off exit (R) on Beulah

SUBDIVISION n/a BLOCK / SECTION n/a LOT ~~Exist~~ LOT AREA .94± SITE CLASS. PS DESIGN FLOW 360 L.T.A.R. Ex

Septic Tank: Ex Gallons: STB Date

Pump Tank: Gallons: PT Date

Pump Make: Model Serial No.

Nitrification Field: No Fields Ex Square Feet Ex Linear Feet Ex

No Lines Ex Trench Width Ex Max Trench Bottom Depth Ex Gravel Depth ☒ Gravity ☐ Pressure

☐ New System ☐ Repair ☐ Expansion System Type: I (II) III IV V VI

System Description: Ex.

Repair System Description: Ex

Maintenance Agreement Required: ☐ Yes ☐ No

☐ House/Mod. Home No. Bedrooms 3

☒ Mobile Home No. Persons

☐ Business No. Employees

☐ Other

Water Supply: ☒ Individual ☐ Public ☐ Community


☐ Slab ☒ Crawl Space ☐ Basement w/plumbing ☐ Basement wo/plumbing

Comments:/Conditions:

Comments:/Conditions:

INITIAL SITE SKETCH

AS BUILT SKETCH

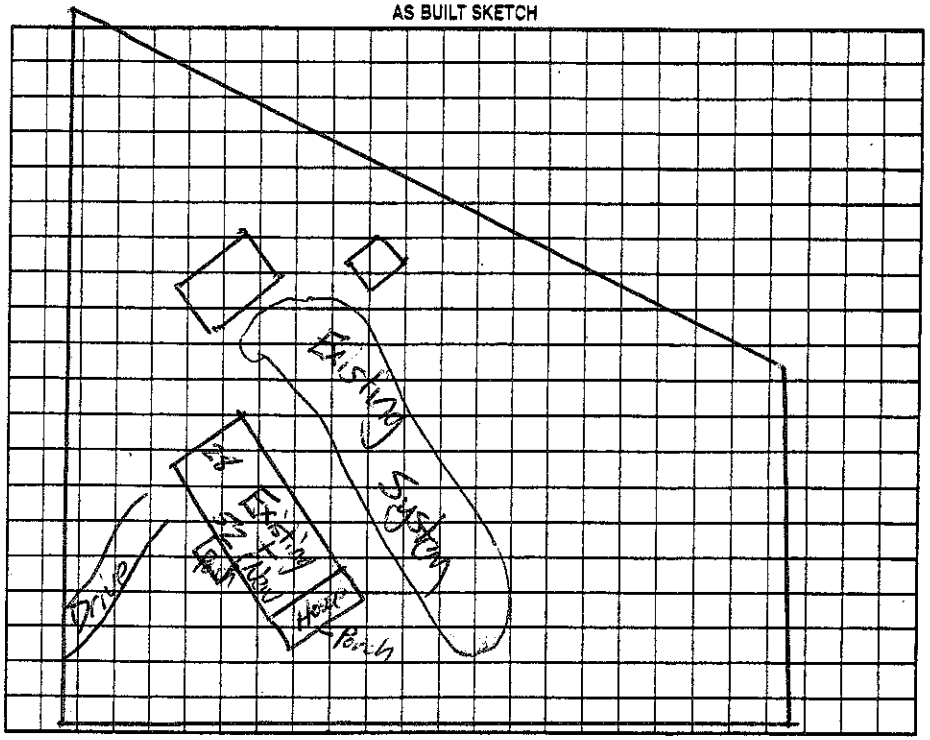

Permit can be suspended or revoked if any false information is supplied toward securing the permit/any unauthorized changes are made to the site/any unauthorized changes are made in the installation of the system. Improvement Permit with plat valid without expiration ☐ Improvement Permit with site plan valid for sixty months ☐ Authorization to Construct is valid for a period equal to that of Improvement Permit – not to exceed sixty months.

Signed: date 3-24-08 Installed by: James Hartness

Improvement Permit by: date Operation Permit by: date

Authorization to Construct by: date Existing System Inspection by: date 3-20-08

HEALTH DEPT. COPY: WHITE OWNER COPY (FINAL): YELLOW OWNER COPY (INITIAL): PINK