IREDELL COUNTY HEALTH DEPARTMENT

4704390763 50576

STATESVILLE 704-878-5305 MOORESVILLE 704-664-5281

IMPROVEMENT PERMIT / CERTIFICATE OF COMPLETION / OPERATION PERMIT / EXISTING SYSTEM INSPECTION

PROPERTY DESCRIPTION NO. 15862 DATE 7-18-94 TAX MAP NO. 8T-2-A-2

OWNER OR CONTRACTOR Ronnie C. Hegan PHONE: Business Home 873-0099 Watershed: ☐ Yes ☑ No

ADDRESS

LOCATION I-40W TR Old Mtn. Rd. Lot on R in corner of Alpine Circle and Old Mtn. Rd.

SUBDIVISION Alexander Farm. BLOCK / SECTION LOT 2 LOT AREA 2.6 acres SITE CLASS. P.S. DESIGN FLOW 360 L.T.A.R. .3 gpd / ft²

Septic Tank: 1000 Gallons; STB 1012 Date 4-19-94

Pump Tank: — Gallons; PT — Date —

Pump Make: — Model — Serial No. —

Nitrification Field: No Fields 1 Square Feet 1200 Linear Feet 400'

No Lines 3 Trench Width 36" Max Trench Bottom Depth 36" Gravel Depth 12"

☑ New System ☐ Repair System Type: I ☑ II III IV V VI

System Description: conventional, gravity fed

Repair System Description: "

Maintenance Agreement Required: ☐ Yes ☑ No

☐ Slab ☑ Crawl Space ☐ Basement w/plumbing ☐ Basement wo/plumbing

☑ House/Mod. Home No. Bedrooms 3

☐ Mobile Home No. Bathrooms 3

☐ Business No. Employees

☐ Other

Water Supply: ☐ Individual ☐ Community ☑ Public

Comments:

Comments: 100% Repair below system, conventional, gravity fed. Keep proposed pool 15' from any part of septic system and repair area. Recommend that tank be pumped at least every 5 years.

INITIAL SITE SKETCH


Location of the proposed 18' x 13' addition does not appear to impact the existing on-site septic system.**NOTE:

REHS

Date: 5-29-13

ICHD-Environmental Health Division

AS BUILT SKETCH

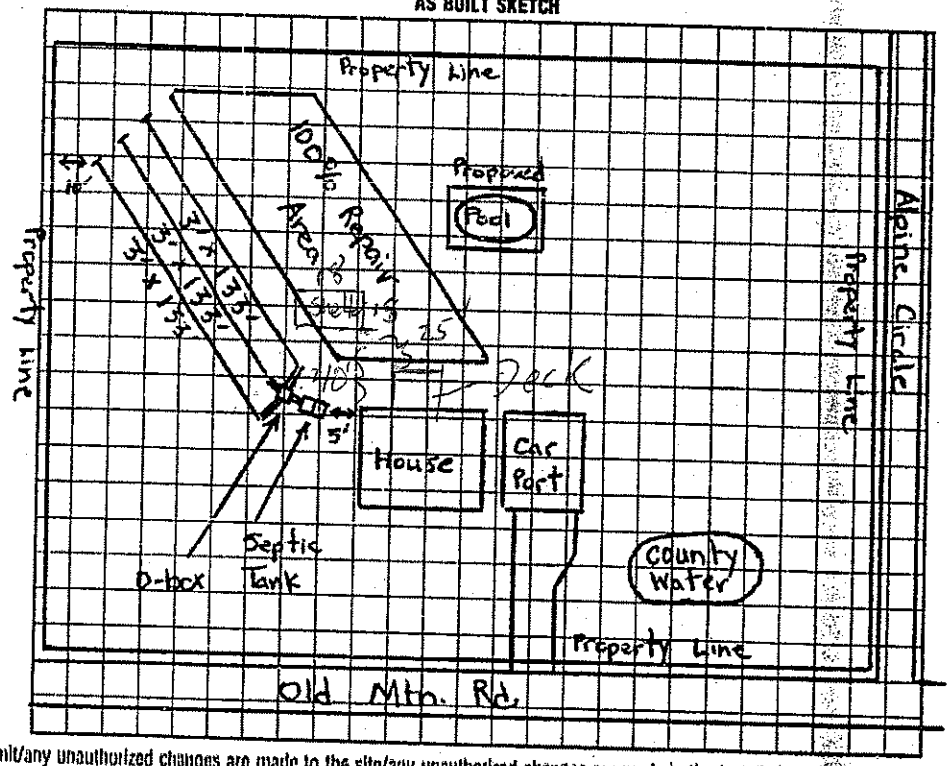

I understand that this permit can be suspended or revoked if any false information is supplied toward securing the permit/any unauthorized changes are made to the site/any unauthorized changes are made in the installation of the system. Improvement Permit is valid for 60 months from date of issuance.

Signed:

Improvement Permit by: Steve Hedrick / Michael J. Dennis date 2-23-93

Existing System Inspection by: date

Installed by: Tommy Frye

Certificate of Completion by: Michael J. Dennis date 7-18-94

Operation Permit by: date

HEALTH DEPT. COPY: WHITE INSPECTION COPY (FINAL): GREEN OWNER COPY (FINAL): YELLOW INSPECTION COPY (INITIAL): PINK OWNER COPY (INITIAL): GOLD