IREDELL COUNTY HEALTH DEPARTMENT

STATESVILLE 704-878-5305 MOORESVILLE 704-664-5281

IMPROVEMENT PERMIT / AUTHORIZATION TO CONSTRUCT / OPERATION PERMIT / EXISTING SYSTEM INSPECTION

PERMIT# Repair PIN# 4704-41-2162 DATE 10/10/03

OWNER OR CONTRACTOR Boston Wilcox PHONE: Business — Home (704) 822-8359

ADDRESS 127 Oak Grove Statesville N.C. 28677

LOCATION I-40 W, @ Oakman Rd, @ Beckett Road, under I-40 (L) wing drive @ 108 Wing Drive

SUBDIVISION — BLOCK / SECTION — LOT — LOT AREA ~3.5 Ac. SITE CLASS. 5 DESIGN FLOW 240 L.T.A.R. .25

Septic Tank: ~~Existing~~ 1000 Gallons; STB 1012 Date 4-16-03

Pump Tank: — Gallons; PT — Date —

Pump Make: — Model — Serial No. —

Nitrification Field: No Fields 1 Square Feet 960 Linear Feet 25

No Lines 3 Trench Width ~~36~~ 30" Max Trench Bottom Depth 36" Gravel Depth 18"

☐ New System ☒ Repair System Type: I (II) III, IV, V, VI

System Description: Gravity Conventional

Repair System Description: —

Maintenance Agreement Required: ☐ Yes ☒ No

☐ House/Mod. Home ☒ Mobile Home ☐ Business ☐ Other

No. Bedrooms 2 No. Bathrooms 2 No. Employees —


☐ Slab ☒ Crawl Space ☐ Basement w/plumbing ☐ Basement wo/plumbing

Water Supply: ☐ Individual ☒ Public ☐ Community


Comments/Conditions: ① Install 3 liner with 18" of Gravel on Contour ② Use Existing Septic Tank if on owners property. Otherwise replace tank with 1000 gallon tank (Not to scale)

Comments/Conditions: - New Septic Tank installed w/ Tuff-Tite Filter + ST markers. Middle line + bottom line okay 10/29/03 (Not to Scale)

INITIAL SITE SKETCH

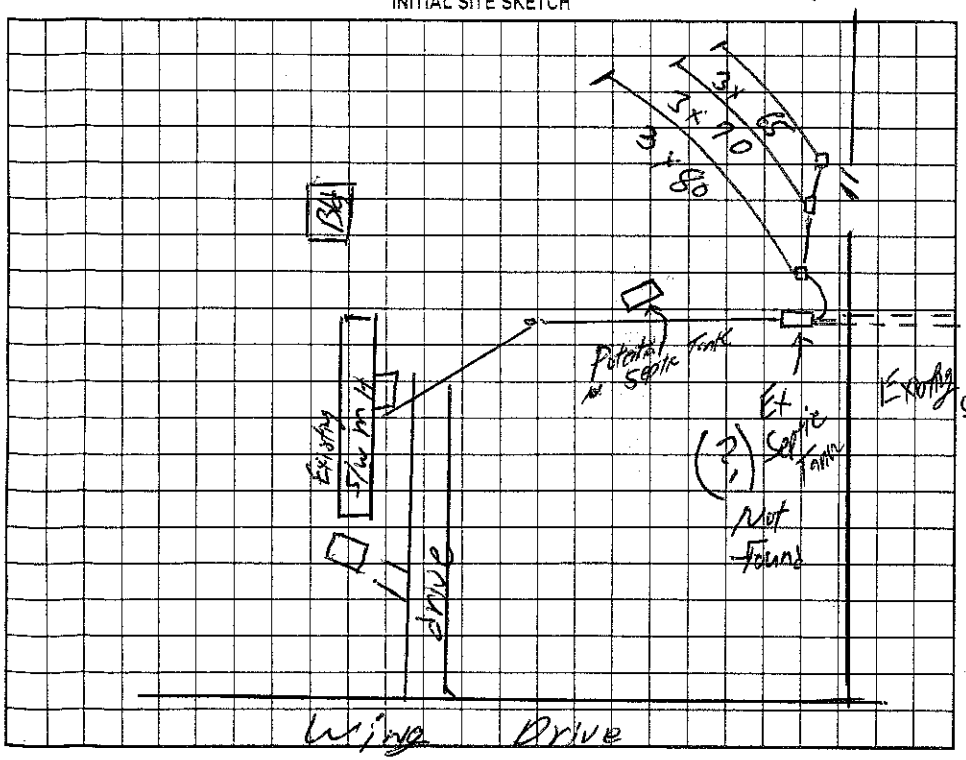

AS BUILT SKETCH

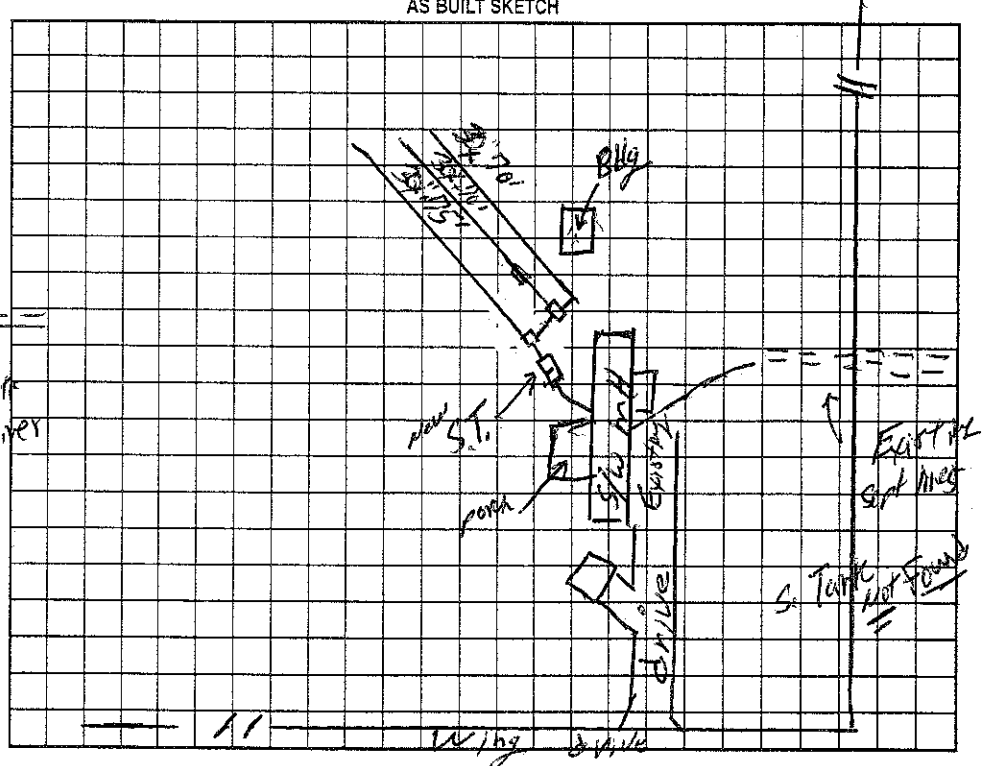

Permit can be suspended or revoked if any false information is supplied toward securing the permit/any unauthorized changes are made to the site/any unauthorized changes are made in the installation of the system. Improvement Permit with plat valid without expiration, Improvement Permit with site plan valid for sixty months. Authorization to Construct is valid for a period equal to that of Improvement Permit – not to exceed sixty months.

Signed: [signature] date 10/16/03 Installed by: Union Grove Septic

Improvement Permit by: William O. Johnson date 10/6/03 Operation Permit by: Steve Hedrick date 10-30-03

Authorization to Construct by: William O. Johnson date 10/9/03 Existing System Inspection by: — date —

HEALTH DEPT. COPY: WHITE OWNER COPY (FINAL): YELLOW OWNER COPY (INITIAL): PINK