IREDELL COUNTY HEALTH DEPARTMENT

STATESVILLE 704-878-5305 MOORESVILLE 704-664-5281

IMPROVEMENT PERMIT / AUTHORIZATION TO CONSTRUCT / OPERATION PERMIT / EXISTING SYSTEM INSPECTION

PERMIT# 78603 PIN# 4704440297 DATE 1-9-99

OWNER OR CONTRACTOR Timothy Hager PHONE: Business Home 871 8856

ADDRESS 1371 Island Ford Rd

LOCATION I-40 W TR Onto TL Island Ford 1/2 mi L-hand

SUBDIVISION BLOCK / SECTION LOT LOT AREA approx 1.2 acre SITE CLASS P3 DESIGN FLOW 360 L.T.A.R. 1.25

Septic Tank: 1000 Gallons; STB 794 Date 11-29-78
Pump Tank: Gallons; PT Date
Pump Make: Model Serial No.
Nitrification Field: No Fields 1 Square Feet 1440 Linear Feet 480
No Lines 4 Trench Width 36" Max Trench Bottom Depth 36" Gravel Depth 12"


☑ New System ☐ Repair System Type: ☐ I ☐ II ☐ III ☐ IV ☐ V ☐ VI
System Description: Conv. Gravity
Repair System Description:
Maintenance Agreement Required: ☐ Yes ☑ No

☑ House/Mod. Home No. Bedrooms 3
☐ Mobile Home No. Bathrooms 2
☐ Business No. Employees
☐ Other
☐ Slab ☑ Crawl Space ☐ Basement w/plumbing ☐ Basement wo/plumbing

Water Supply: ☐ Individual ☑ Public ☐ Community

Comments/Conditions:

INITIAL SITE SKETCH

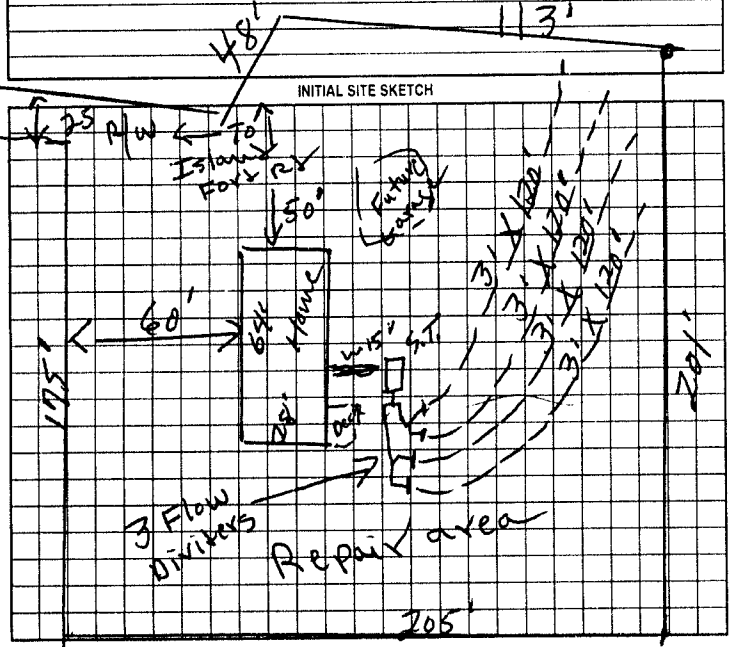

Comments/Conditions:

AS BUILT SKETCH

Permit can be suspended or revoked if any false information is supplied toward securing the permit/any unauthorized changes are made to the site/any unauthorized changes are made in the installation of the system. Improvement Permit with plat valid without expiration. Improvement Permit with site plan valid for sixty months. Authorization to Construct is valid for a period equal to that of Improvement Permit – not to exceed sixty months.

Signed: X. Timothy J. Hager date 1-9-99 Installed by: A Cornelius Grading

Improvement Permit by: P.C. Moore date 1-9-99 Operation Permit by: Mark C O.J PCS date 3-5-99

Authorization to Construct by: P.C. Moore date 1-9-99 Existing System Inspection by: date

HEALTH DEPT COPY WHITE OWNER COPY (FINAL) YELLOW OWNER COPY (INITIAL) PINK