IREDELL COUNTY HEALTH DEPARTMENT

STATESVILLE 704-878-5305 MOORESVILLE 704-664-5281

IMPROVEMENT PERMIT / AUTHORIZATION TO CONSTRUCT / OPERATION PERMIT / EXISTING SYSTEM INSPECTION

PERMIT# REPAIR PIN# 4704-47-2995.12 DATE 8-28-06

OWNER OR APPLICANT JOHN THOMAS LYONS PHONE: Business Home 704-871-0015

ADDRESS 2267 OLD MOUNTAIN ROAD, STATESVILLE, NC 28625-2557

LOCATION I-40 WEST TR OLD MOUNTAIN ROAD 2ND HOUSE ON LEFT PAST ISLAND FORD ROAD

SUBDIVISION BLOCK / SECTION LOT LOT AREA AMPLE SITE CLASS. PS DESIGN FLOW 360 L.T.A.R. 0.3 GPD/FT²

Septic Tank: EXISTING Gallons; STB Date

Pump Tank: Gallons; PT Date

Pump Make: Model Serial No.

Nitrification Field: No Fields 1 Square Feet 1200 Linear Feet 400

No Lines FOUR Trench Width 36" Max Trench Bottom Depth 36" Gravel Depth 12"

☒ New System ☒ Repair ☐ Expansion System Type: I II III IV V VI

System Description:

Repair System Description: CONVENTIONAL, GRAVITY

Maintenance Agreement Required: ☐ Yes ☒ No

☒ House/Mod. Home No. Bedrooms 3

☐ Mobile Home No. Persons

☐ Business No. Employees

☐ Other

Water Supply: ☐ Individual ☒ Public ☐ Community


☒ Gravity ☐ Pressure ☐ Slab ☒ Crawl Space ☐ Basement w/plumbing ☐ Basement wo/plumbing

Comments:/Conditions: ① SEE ATTACHED DEED FOR PROPERTY LINE (ONE TRACT CREATED OUT OF TWO TRACTS) ② AN "ACCEPTED" SYSTEM MAY ALSO BE USED. ③ ABANDON EXISTING DRAINFIELD


Comments:/Conditions:

1 = 18
2 = 23
3 = 26
4 = 6

INITIAL SITE SKETCH

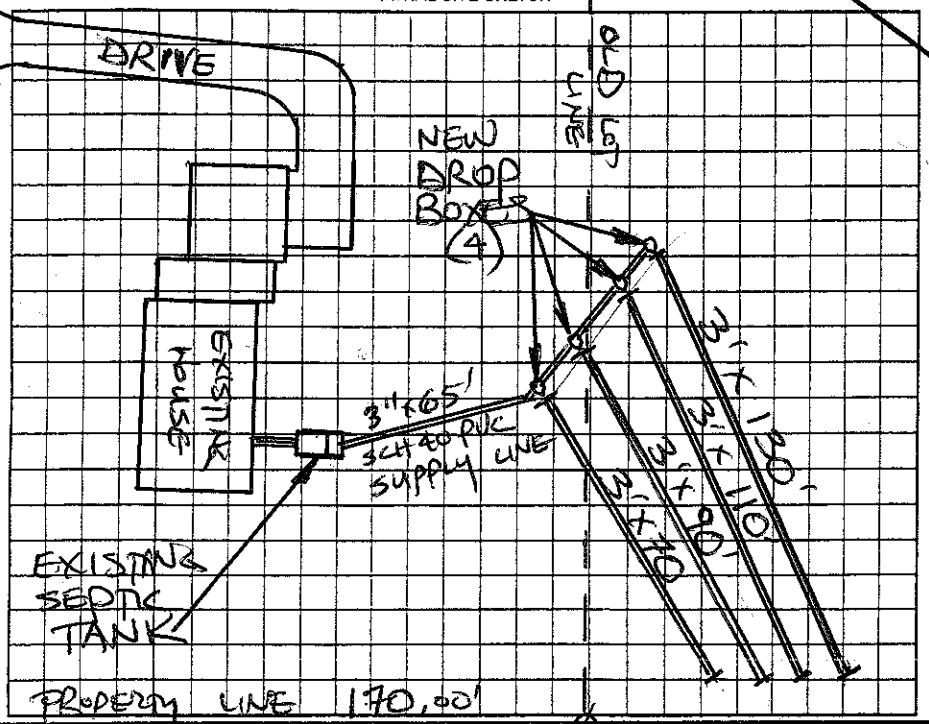

AS BUILT SKETCH

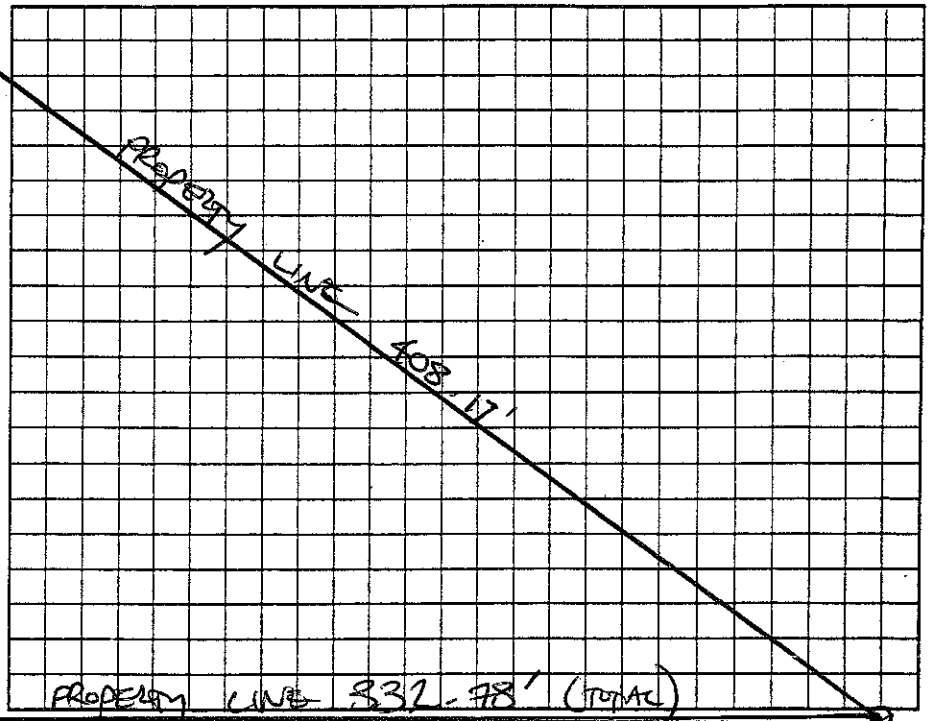

OLD MOUNTAIN ROAD

Permit can be suspended or revoked if any false information is supplied toward securing the permit/any unauthorized changes are made to the site/any unauthorized changes are made in the installation of the system. Improvement Permit with plat valid without expiration ☐ Improvement Permit with site plan valid for sixty months ☒ Authorization to Construct is valid for a period equal to that of Improvement Permit – not to exceed sixty months.

Signed: John T Lyons date 8-28-06 Installed by: Andy Daniels

Improvement Permit by: STEVE HEDRICK date 8-28-06 Operation Permit by: date 9-6-06

Authorization to Construct by: STEVE HEDRICK date 8-28-06 Existing System Inspection by: date

HEALTH DEPT. COPY: WHITE OWNER COPY (FINAL): YELLOW OWNER COPY (INITIAL): PINK