IREDELL COUNTY HEALTH DEPARTMENT

Statesville Phone TR 3-7271 Mooresville Phone NO 3-1271

PERMIT TO INSTALL SEPTIC TANK

Permit NO. _____ Permit Date January 28th 1958

Owner C.D. BRADY Address Rt. 6, Statesville, N.C.

Installed By CLYDE HOKE Address Charlotte Hgwy, Statesville


Location of Property Go past Bradford's Cross Roads toward Hiddenite - 1st house on right, brick.

Tank		Capacity		Length of Lines		Fixtures	
Block	( )	800	( )	150'	( )	No. of Baths	(1)
Precast	(X)	900	( )	175'	( )	Dishwasher	( )
		1000	(✓)	200'	( )	Garbage Grdr.	( )
		1100	( )	225'	(✓)	Auto-Washer	(1)
		1200	( )	250'	( )	Other	
		Other		Other			

NOTIFY HEALTH DEPARTMENT AT LEAST EIGHT HOURS BEFORE TANK IS TO BE INSPECTED.

Final Inspection January 28th 1958 Approved (X) Disapproved ( )

Remarks _____

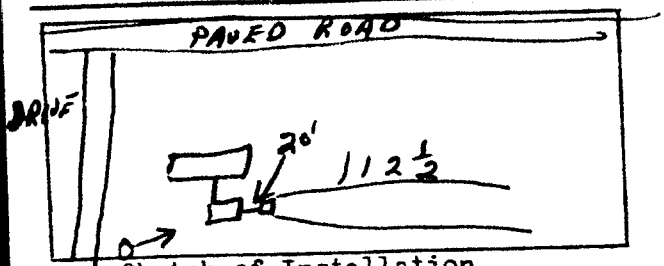

Sketch of Installation

Raford A. Thomas

Sanitarian