IREDELL COUNTY HEALTH DEPARTMENT

Statesville Office (704) 878-5305 Mooresville Office (704) 660-3625 PERMIT # 201142

IMPROVEMENT PERMIT / AUTHORIZATION TO CONSTRUCT / OPERATION PERMIT / EXISTING SYSTEM

PIN # 4704481853

APPLICANT: Frank Gmory APPLICANT ADDRESS: 115 Colonial Heights Ln.

SITE ADDRESS: 115 Colonial Heights Ln. PHONE: 704-902-4015 ALT. PHONE: N/A

SITE DIRECTIONS: I-40W to OW Mtn Rd TR Old Mtn Rd TR Colonial Height Ln.


SUBDIVISION: Colonial Acres SECTION: N/A LOT # 5-10 LOT AREA: .45 acres DESIGN FLOW: 360gpd L.T.A.R.: Existing

Septic Tank	1000	(gal)	STB	760-1060	Date	9-17	☐ New System	☑ Repair	☐ Expansion	System Type: I	II III IV V VI
Pump Tank		(gal)	PT		Date		System Description:				
Pump Make		Model			Serial #		Repair System Description:	TANK			
# Nitrification Fields	1	# Lines	6x		Linear Ft:	6x	Maintenance Agreement Required:	☐ YES	☑ NO		
Trench Width	6x	Max. Trench Bottom Depth	6x		Gravel Depth	6x		☑ GRAVITY	☐ PRESSURE		

☑ Residence	No. Bedrooms	3	Water Supply
☐ Business	No. Persons	6	☐ Private
☐ Other	No. Employees		☑ Public
☐ Slab	☐ Crawl Space		☐ Community
☐ Basement w/plumbing			☑ Basement w/o plumbing

Comments / Conditions: Install a 1000 gallon septic at location shown below & connect to existing drainfield. Exact location of existing drainfield is not known due to depth of existing drainfield. Pump & crush existing septic tank. Install risers on new septic tank if deeper than 6" below finished grade.

INITIAL SITE SKETCH

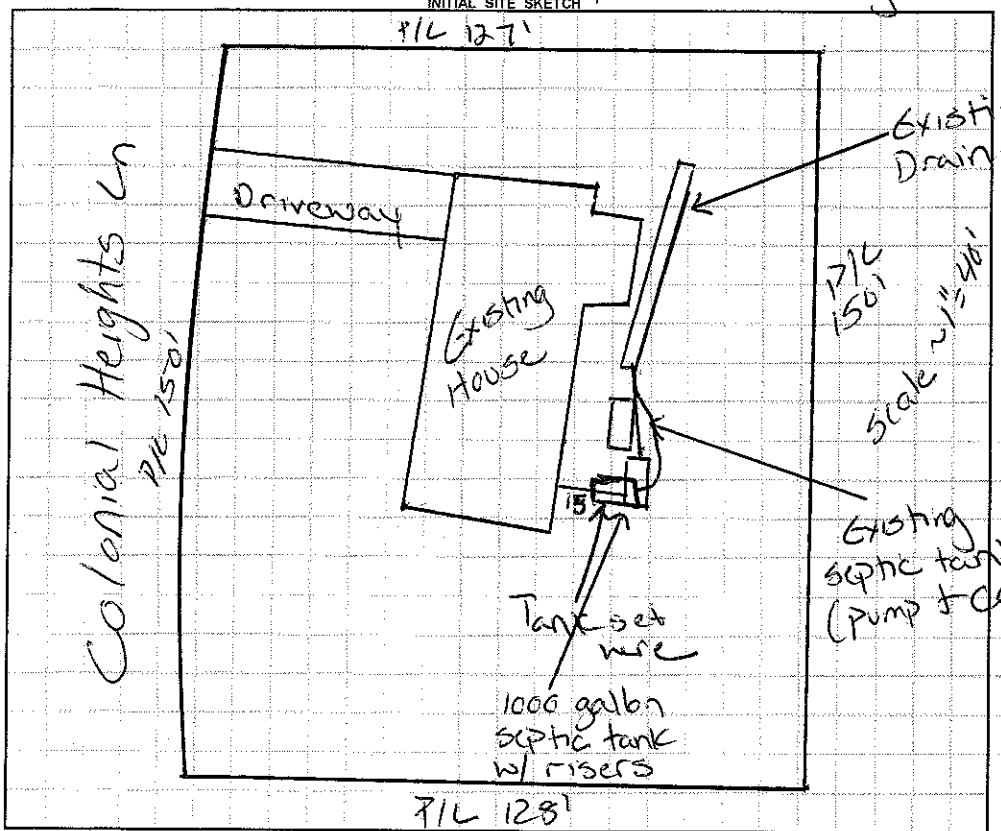

AS BUILT SKETCH

- Red Polylok Setter
- Installed as drawn

Permit can be suspended or revoked if any false information is supplied toward securing the permit / any unauthorized changes are made to the site / any unauthorized changes are made in the installation of the system. **CONTACT A LOCATOR SERVICE PRIOR TO ANY EXCAVATION**

☐ **IMPROVEMENT PERMIT** *with plat valid without expiration.* ☑ **IMPROVEMENT PERMIT** *with site plan valid for 60 mos.* ☑ **AUTHORIZATION TO CONSTRUCT** *valid for period equal to IMPROVEMENT PERMIT--not to exceed 60 mo.*

Owner / Applicant Signature: Dennis Gallehe Date: 2-3-14 Installed by: A1 Backhoe

IMPROVEMENT PERMIT by: Justin Henderson Date: 1-29-14 OPERATION PERMIT by: Justin Henderson Date: 3-27-14

AUTHORIZATION TO CONSTRUCT by: Justin Henderson Date: 1-29-14 Existing System Inspected by: Date:

Health Dept. Copy - WHITE Applicant (Final Approval) - YELLOW Applicant (Conditional Approval) - PINK