IREDELL COUNTY HEALTH DEPARTMENT - *ENVIRONMENTAL HEALTH* ☑ STATESVILLE OFFICE 704-878-5305 ☐ MOORESVILLE OFFICE 704-664-5281

IMPROVEMENT PERMIT / AUTHORIZATION TO CONSTRUCT (P) / OPERATION PERMIT @ EXISTING SYSTEM INSPECTION

PERMIT # 170894 PIN # 4704.48-2915 DATE MARCH 6, 2012

OWNER JUDY GURLEY WEST APPLICANT: SAME PHONE: Home/Cell # 704-929-0983 Business #

SITE ADDRESS COLONIAL HEIGHTS LANE OWNER / APPLICANT ADDRESS P.O. BOX 558, INDEPENDENCE, VA 24348

SITE DIRECTIONS I-40 WEST TROUT MOUNTAIN ROAD, R COLONIAL HEIGHTS LANE, 3RD LOT ON LEFT

SUBDIVISION COLONIAL ACRES BLOCK / SECTION N/A LOT # 11 LOT AREA 0.296 AC DESIGN FLOW 240 L.T.A.R. 0.30 GPD/FT2

Septic Tank 1000 Gallons: STB 760 Date 10-1

Pump Tank ____ Gallons: P T ____ Date ____

Pump Make ____ Model ____ Serial # ____

No. Nitrification Fields: 1 No. Lines 7 Linear Feet 200'

Trench Width 36" Max. Trench Bottom Depth 36" ~~Min. Depth 24"~~ N/A

☑ New System ☐ Repair ☐ Expansion System Type I II (III) IV V VI

System Description: 25% REDUCTION GRAVITY

Repair System Description: 50% REDUCTION PUMP

Maintenance Agreement Required ☐ YES ☑ NO

☑ GRAVITY ☐ PRESSURE

☑ Residence No. Bedrooms 2

☐ Business No. Persons ____

☐ Other No. Employees ____


☐ Slab ☑ Crawl Space

☐ Basement w/plumbing ☐ Basement w/o plumbing

Water Supply: ☐ Private ☑ Public ☐ Community

Comments / Conditions: INSTALL 25% REDUCTION SYSTEM ON CONTOUR AS SHOWN USING SERIAL DISTRIBUTION.

INITIAL SITE SKETCH

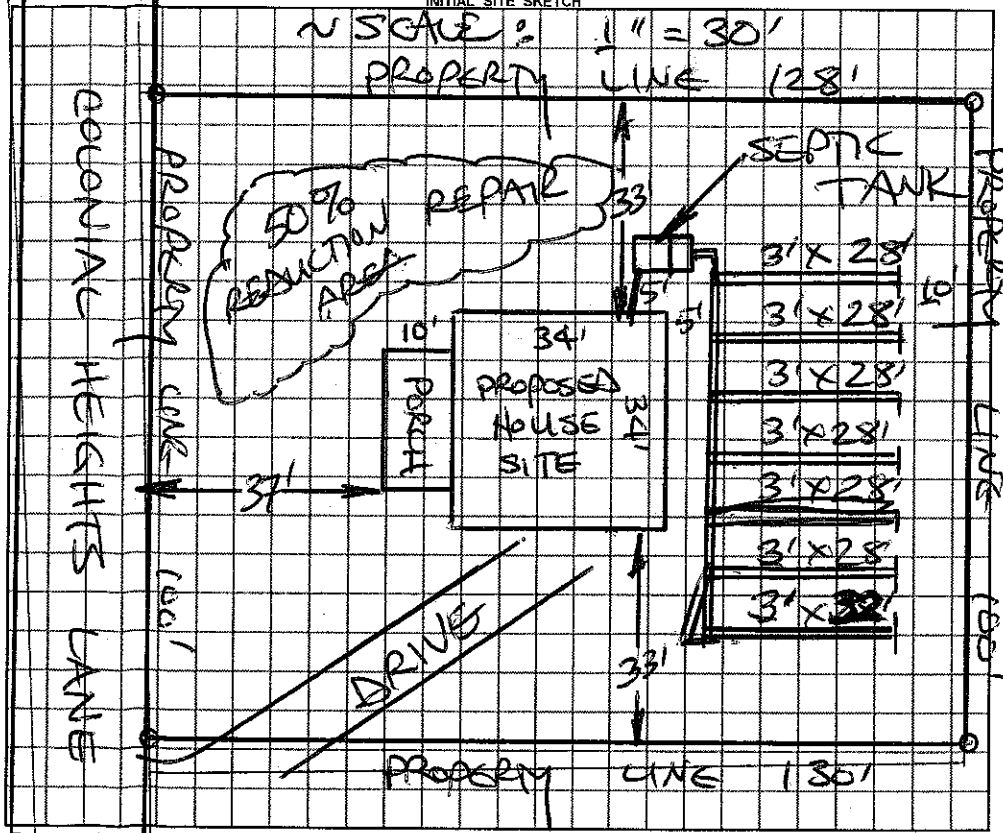

AS BUILT SKETCH

Permit can be suspended or revoked if any false information is supplied toward securing the permit / any unauthorized changes are made to the site / any unauthorized changes are made in the installation of the system.

☐ *IMPROVEMENT PERMIT with plat valid without expiration.* ☑ *IMPROVEMENT PERMIT with plat valid without expiration. site plan valid 60 mo.* ☑ *AUTHORIZATION TO CONSTRUCT* valid for period equal to IMPROVEMENT PERMIT--not to exceed 60 mo.

Owner / Applicant Signature: Judy West Date 3/12/12 Installed by: A-1 Backhoe

IMPROVEMENT PERMIT by: R. STEVE HEDRICK REHS Date 3/6/12 OPERATION PERMIT by: ____ REHS Date 4-23-12

AUTHORIZATION TO CONSTRUCT by: R. STEVE HEDRICK REHS Date 3/6/12 Existing System Inspected by: ____ REHS Date ____

YOU SHOULD CONTACT A LOCATOR SERVICE PRIOR TO ANY EXCAVATION

White Copy – Environmental Health YELLOW COPY (Final) Owner / Applicant PINK COPY (Initial) Owner / Applicant