IREDELL COUNTY HEALTH DEPARTMENT

Statesville Phone TR 3-7271 Mooresville Phone NO 3-1271

PERMIT TO INSTALL SEPTIC TANK

Permit No. 123 Permit Date _____ 19__

Owner Bobby Combs Address Stoney Point

Installed By Harlee Lackey Address Stoney Point


Location of Property out I-40 to Old Mountain Rd T.R 90 to 2nd Paved Rd past Bradfords X Roads # 1643 T.R. House on left

| Tank | | Capacity | | Length of Lines | | Fixtures | |
|---|---|---|---|---|---|---|---|
| Block | ( ) | 1000 | (✓) | 225' | ( ) | No. of Baths | (2) |
| Precast | (✓) | 1250 | ( ) | 250' | ( ) | Dishwasher | ( ) |
| | | 1500 | ( ) | Other 240 | | Garbage Grdr. | ( ) |
| | | Other _____ | | | | Other _____ | |

NOTIFY HEALTH DEPARTMENT AT LEAST EIGHT HOURS BEFORE TANK IS TO BE INSPECTED.

Final Inspection 3-6 1972 Approved (✓) Disapproved ( )

Remarks _____

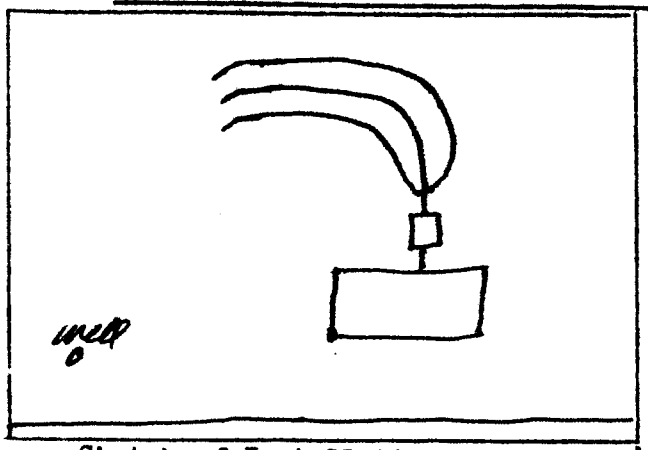

Sketch of Installation

E. G. Stevenson

Sanitarian