IREDELL COUNTY HEALTH DEPARTMENT

STATESVILLE 704-878-5305 MOORESVILLE 704-664-5281

IMPROVEMENT PERMIT / AUTHORIZATION TO CONSTRUCT / OPERATION PERMIT / EXISTING SYSTEM INSPECTION

PERMIT # Repair 176093 PIN # 4704495267 DATE 12-6-12

OWNER or APPLICANT Shirley Lawson PHONE: Business 704-872-2346 Home:

OWNER or APPLICANT ADDRESS 142 Colonial Heights

LOCATION / DIRECTIONS Old Mountain Rd to Colonial Heights ln, 5th Road on (R)

SUBDIVISION Colonial Acres BLOCK / SECTION n/a LOT # 66 LOT AREA 0.5 DESIGN FLOW 360 L.T.A.R. 1/2

Septic Tank 1000 Gallons: STB 760 Date 7-24-12

Pump Tank ____ Gallons: P T ____ Date ____

Pump Make ____ Model ____ Serial # ____

Nitrification Field No Fields 1 No Lines Ex Linear Feet Ex

Trench Width Ex Max. Trench Bottom Depth Ex Gravel Depth Ex

☐ New System ☒ Repair ☐ Expansion System Type I (II) III IV V VI

System Description: ____

Repair System Description: TANK

Maintenance Agreement Required ☐ YES ☒ NO

☒ GRAVITY ☐ PRESSURE

☒ Residence No. Bedrooms 3

☐ Business No. Persons ____

☐ Other No. Employees ____

☐ Slab ☐ Crawl Space


☒ Basement w/plumbing ☐ Basement w/o plumbing

Water Supply: ☐ Private ☒ Public ☐ Community

Comments / Conditions

Comments / Conditions

INITIAL SITE SKETCH

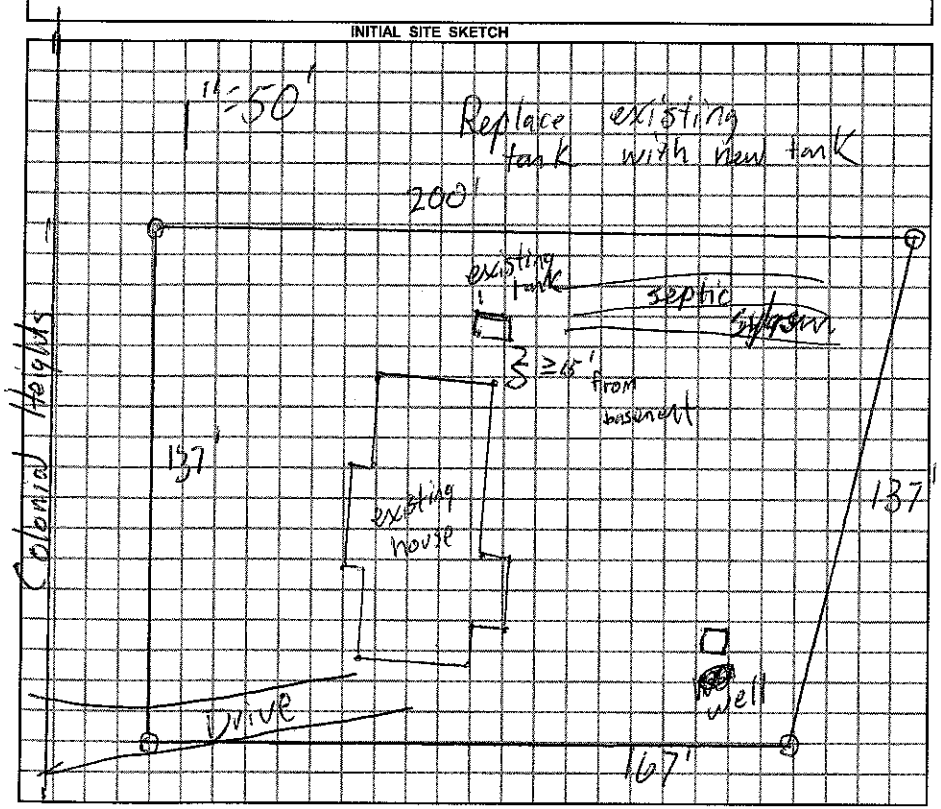

AS BUILT SKETCH

Permit can be suspended or revoked if any false information is supplied toward securing the permit / any unauthorized changes are made to the site / any unauthorized changes are made in the installation of the system.

☐ *IMPROVEMENT PERMIT w / plat valid without expiration.* ☒ *IMPROVEMENT PERMIT w / site plan valid for 60 mos.* ☒ *AUTHORIZATION TO CONSTRUCT valid for period equal to IMPROVEMENT PERMIT-not to exceed 60 mo.*

Owner / Applicant Signature: ____ Date 12/10/12

Improvement Permit by: ____ Date 12-6-12

Authorzation to Construct by: ____ Date 12-6-12

YOU SHOULD CONTACT A LOCATOR SERVICE PRIOR TO ANY EXCAVATION.

Installed by: Jared Lentz

Operation Permit by: ____ Date: 01-8-13

Existing System Inspected by: ____ Date: ____

WHITE COPY Environmental Health YELLOW COPY (Final) Owner / Applicant PINK COPY (Initial) Owner / Applicant