IREDELL COUNTY HEALTH DEPARTMENT

Statesville Phone TR 3-7271 — Mooresville Phone NO 3-1271

Permit No. ~~[illegible]~~ 117 — PERMIT TO INSTALL SEPTIC TANK — Permit Date _____ 19__

Owner Bobby Combs Address _____

Installed By Harlee Lackey Address _____


Location of Property Old Mt Road; 2nd paved rt (dead end) past Bradfords X-roads. Last house on right.

Tank		Capacity		Length of Lines		Fixtures	
Block	( )	1000	( )	225'	(✓)	No. of Baths	(2)
Precast	(✓)	1250	( )	250'	( )	Dishwasher	( )
		1500	( )	Other _____		Garbage Grdr.	( )
		Other _____				Other _____	

NOTIFY HEALTH DEPARTMENT AT LEAST EIGHT HOURS BEFORE TANK IS TO BE INSPECTED.

Final Inspection 6-8 1972 — Approved (✓) Disapproved ( )

Remarks Too many tree roots extending into ditch. Could give trouble later.

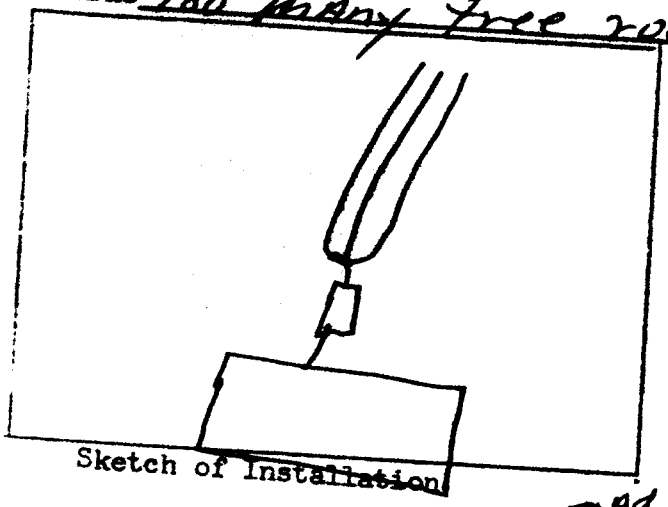

Sketch of Installation

Road

Sanitarian