IREDELL COUNTY HEALTH DEPARTMENT

Statesville Phone TR 3-7271 Mooresville Phone NO 3-1271

PERMIT TO INSTALL SEPTIC TANK

Permit NO. _____ Permit Date 11-19- 195X

Owner Benfield Address Rt 8

Installed By C Hoke Address R7-


Location of Property Left at Beulah ch. before by pass, on left behind garage.

Tank		Capacity		Length of Lines		Fixtures	
Block	( )	800	(4)	150'	(4)	No. of Baths	(1)
Precast	(4)	900	( )	175'	( )	Dishwasher	( )
		1000	( )	200'	( )	Garbage Grdr.	( )
		1100	( )	225'	( )	Auto-Washer	( )
		1200	( )	250'	( )	Other	
		Other		Other			

NOTIFY HEALTH DEPARTMENT AT LEAST EIGHT HOURS BEFORE TANK IS TO BE INSPECTED.

Final Inspection 11-19 1958 Approved ( ) Disapproved ( )

Remarks Self app. by C Hoke. well on prop.

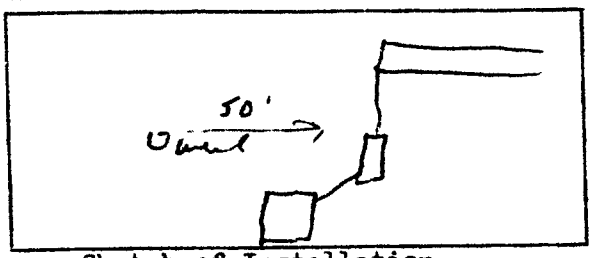

Sketch of Installation

R. G. I.

Sanitarian