IREDELL COUNTY HEALTH DEPARTMENT

Statesville Phone TR 3-7271 — Mooresville Phone NO 3-1271

PERMIT TO INSTALL SEPTIC TANK

Permit No. [illegible] Permit Date June 27 1969

Owner John Byers Address R 6

Installed By C Hoke & Sons Address R 7


Location of Property left old mt. Rd at Beaula Ch. go 1/2 mile on left beyon Byers Garage

Tank		Capacity		Length of Lines		Fixtures	
Block	( )	1000	( )	225'	( )	No. of Baths	(1)
Precast	(✓)	1250	( )	250'	( )	Dishwasher	( )
Cash		1500	( )	Other		Garbage Grdr.	( )
		Other				Other	

NOTIFY HEALTH DEPARTMENT AT LEAST EIGHT HOURS BEFORE TANK IS TO BE INSPECTED.

Final Inspection _____ 19__ Approved ( ) Disapproved ( )

Remarks well 100' - Recomend that willow tree come out.

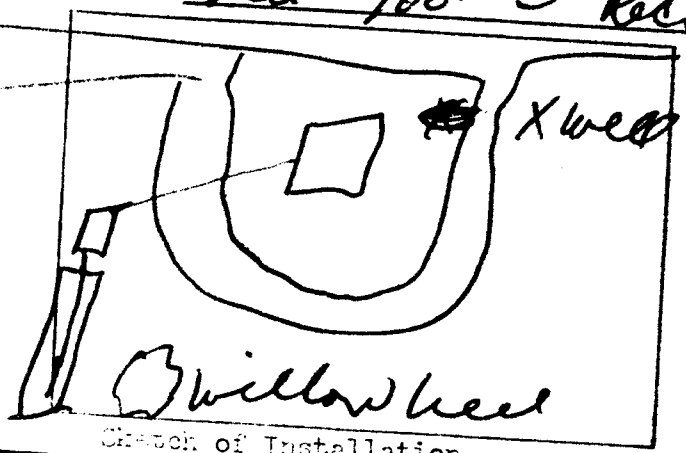

Sketch of Installation

L. F. H.

Sanitarian