IREDELL COUNTY HEALTH DEPARTMENT

Statesville Phone TR 3-7271 Mooresville Phone NO 3-1271

PERMIT TO INSTALL SEPTIC TANK

Permit NO. _____ Permit Date 2-15-1968

Owner Williford Jones Elder. Address R6

Installed By C Hoke Address R7


Location of Property left off old mtn Rd. at Mt. Herman ch. 1st new brick on left.

Tank		Capacity		Length of Lines		Fixtures	
Block	( )	1000	( )	225'	( )	No. of Baths	(2½)
Precast	(✓)	1250	( )	250'	( )	Dishwasher	( )
		1500	( )	Other 255		Garbage Grdr	( )
		Other _____				Other Washer Extra	

NOTIFY HEALTH DEPARTMENT AT LEAST EIGHT HOURS BEFORE TANK IS TO BE INSPECTED.

Final Inspection _____ 19___ Approved ( ) Disapproved ( )

Remarks Very tight red clay. deep because of plumbing owell rough out.

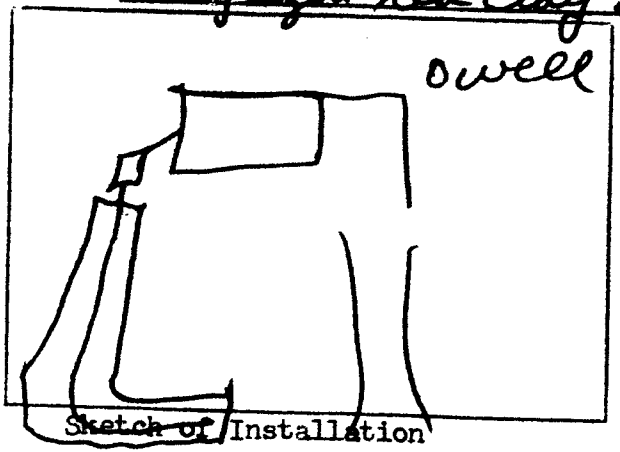

Sketch of Installation

_____

Sanitarian