IREDELL COUNTY HEALTH DEPARTMENT

STATESVILLE 704-878-5305 CI MOORESVILLE 704-664-5281

IMPROVEMENT PERMIT / AUTHORIZATION TO CONSTRUCT / OPERATION PERMIT / EXISTING SYSTEM INSPECTION

PERMIT# 112 834 PIN# 4704-54-5187 704-873-2181 DATE 06-05-03

OWNER OR CONTRACTOR TIMOTHY & SHEILA SHUFORD PHONE: Business CELL 704-880-4303 Home 704-872-3248

ADDRESS 152 MT HERMON RD STATESVILLE, NC 28625

LOCATION I-40 WEST, (R) OMR RD, (L) MT HERMON, (R) BETWEEN FIRST & SECOND HOUSES

SUBDIVISION _____ BLOCK / SECTION _____ LOT _____ LOT AREA 5.92 AC SITE CLASS. PS DESIGN FLOW 480 L.T.A.R. .3

Septic Tank: 1000 Gallons; STB 1612 Date 9-15-03
Pump Tank: _____ Gallons; PT _____ Date _____
Pump Make: _____ Model _____ Serial No. _____
Nitrification Field: No Fields 1 Square Feet 1600' Linear Feet 533'
No Lines 5X107' Trench Width 36" Max Trench Bottom Depth 36" Gravel Depth 12"


(X) New System ☐ Repair System Type: I, (II), III, IV, V, VI
System Description: GRAV CONV
Repair System Description: GRAV / PUMP 25% REDUCT
Maintenance Agreement Required: ☐ Yes (X) No

(X) House/Mod. Home No. Bedrooms 4
☐ Mobile Home No. Bathrooms 3.5
☐ Business No. Employees _____
☐ Other _____
☐ Slab (X) Crawl Space ☐ Basement w/plumbing ☐ Basement wo/plumbing

Water Supply: ☐ Individual (X) Public ☐ Community

Comments:/Conditions: (1) INSTALL 5 LINES 3'x107' AS DRAWN / USING DROP BOXES (2) HOUSE + SYSTEM IS FLAGGED OUT (3) MAINTAIN SETBACKS + INSTALL LINES ON CONTOURS

INITIAL SITE SKETCH "NOT TO SCALE"

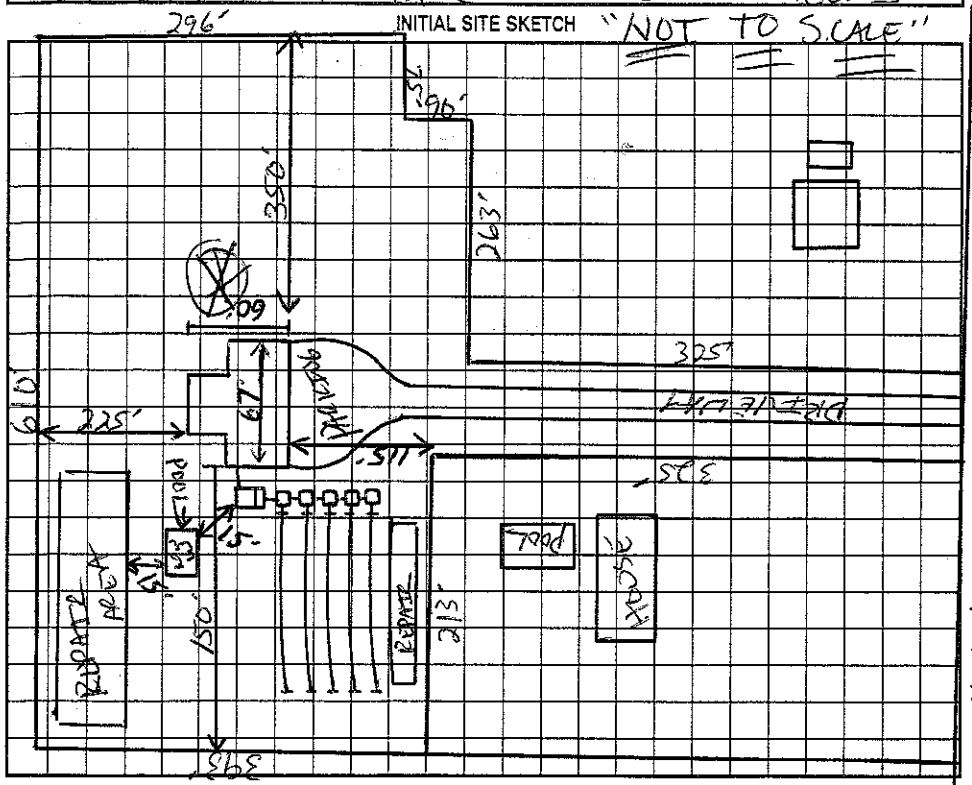

Comments:/Conditions: APPROVED ROTATING HOUSE 90° WHICH MEANS NOW THE 67 x 60 SECTIONS ARE JUST SWITCHED. GARAGE ENTRY IS ALSO CHANGED TOO, INSTEAD OF STRAIGHT IN IT IS NOW TO OPPOSITE END OF HOUSE IN REFERENCE TO THE SEPTIC FIELD, (X) ASTERIC IS WHERE GARAGE & DRIVE ARE GOING NOW. LL 7-29-03, MET WITH THE BUILDER STUBOUT & SIDE OF HOUSE IS STILL THE SAME LOCATION.

AS BUILT SKETCH

Tuff-Tite filter & ST marker Installed

Installed As Shown

Permit can be suspended or revoked if any false information is supplied toward securing the permit/any unauthorized changes are made to the site/any unauthorized changes are made in the installation of the system. Improvement Permit with plat valid without expiration. Improvement Permit with site plan valid for sixty months. Authorization to Construct is valid for a period equal to that of Improvement Permit – not to exceed sixty months.

Signed: Timothy Shuford date 6-5-03 Installed by: Steve Jordan

Improvement Permit by: [signature] date 6-5-03 Operation Permit by: William O. Johnson date 3/5/04

Authorization to Construct by: [signature] date 6-5-03 Existing System Inspection by: _____ date _____

HEALTH DEPT. COPY: WHITE OWNER COPY (FINAL): YELLOW OWNER COPY (INITIAL): PINK