C1

IREDELL COUNTY HEALTH DEPARTMENT

STATESVILLE 704-878-5305 MOORESVILLE 704-664-5281

IMPROVEMENT PERMIT / AUTHORIZATION TO CONSTRUCT / OPERATION PERMIT / EXISTING SYSTEM INSPECTION

PERMIT# 139578 PIN# 4704-58-4644 4585 DATE 15 February 07

OWNER OR APPLICANT Dollar General PHONE: Business 704-663-5270 Home

ADDRESS P.O. Box 1067 Mooresville, N.C. 28115

LOCATION Old Mountain rd. Across from Sallie Drive

SUBDIVISION BLOCK / SECTION LOT 3 LOT AREA 49,400 ft² SITE CLASS. PS DESIGN FLOW 200gpd L.T.A.R. 0.25 gpd/ft²/d

Septic Tank 1000 Gallons; STB RST SRS-025 Date 4-9-07

Pump Tank: Gallons; PT Date

Pump Make: Model Serial No.

Nitrification Field: No Fields 1 Square Feet 800 Linear Feet 200

No Lines 4 Trench Width 36" Max Trench Bottom Depth 24"

☑ New System ☐ Repair ☐ Expansion System Type: I II III IV V VI

System Description: 25% Reduction

Repair System Description: 25% Reduction

Maintenance Agreement Required: ☐ Yes ☐ No

Gravel Depth ☑ Gravity ☐ Pressure

☐ House/Mod. Home No. Bedrooms

☐ Mobile Home No. Persons

☑ Business No. Employees

☐ Other Retail 10,910 ft²

Water Supply: ☐ Individual ☑ Public ☐ Community


☑ Slab ☐ Crawl Space ☐ Basement w/plumbing ☐ Basement wo/plumbing

Comments:/Conditions: Install 25% Reduction system on contour. *24" max. trench depth. Flow-reduction approval attached.


1" = 60'

Comments:/Conditions:

INITIAL SITE SKETCH

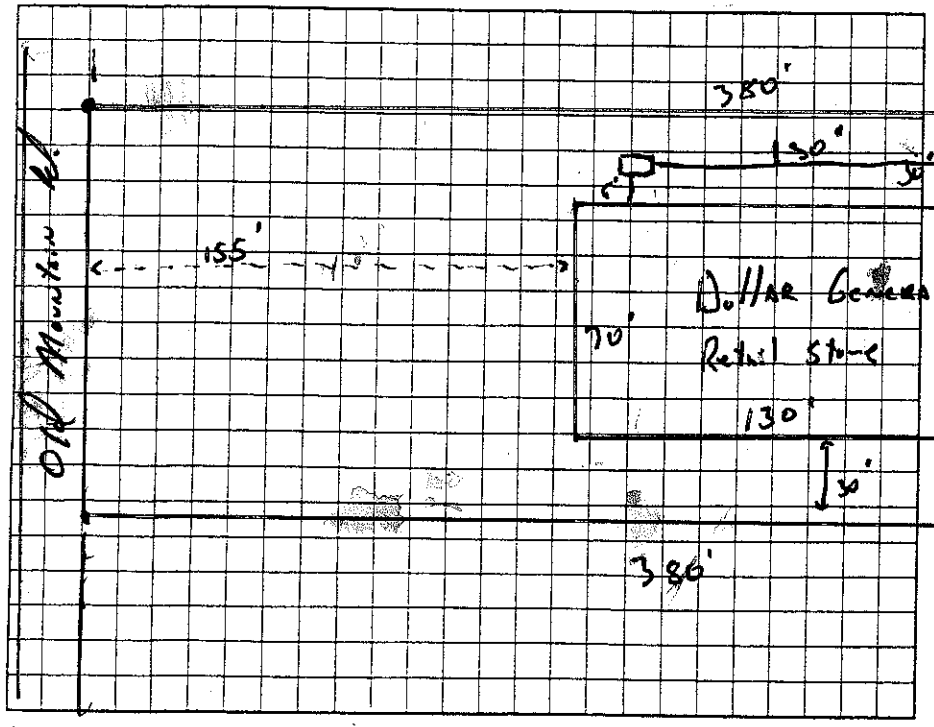

AS BUILT SKETCH

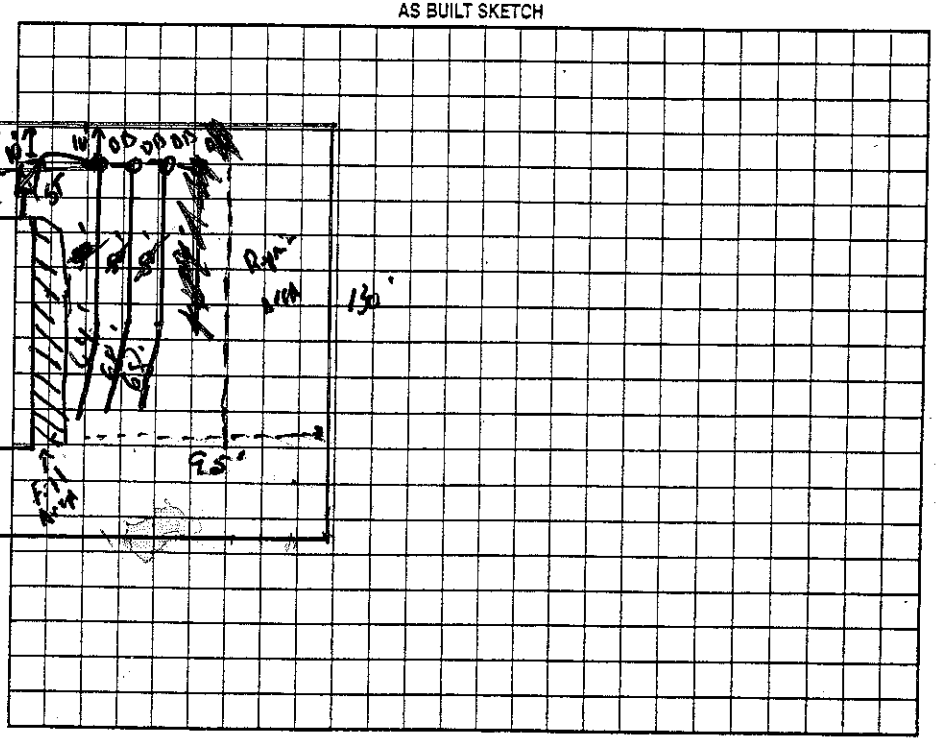

Permit can be suspended or revoked if any false information is supplied toward securing the permit/any unauthorized changes are made to the site/any unauthorized changes are made in the installation of the system. Improvement Permit with plan valid without expiration ☐ Improvement Permit with site plan valid for sixty months ☑ Authorization to Construct is valid for a period equal to that of Improvement Permit – not to exceed sixty months.

Signed: Kamp B Johnson date 2-15-07

Improvement Permit by: D. Hayes, R.S. date 15 Feb.07

Authorization to Construct by: D. Hayes, R.S. date 15 Feb.07

Installed by: Joe Thompson

Operation Permit by: D. Hayes, R.S. date 4 June 07

Existing System Inspection by: date

HEALTH DEPT. COPY: WHITE OWNER COPY (FINAL): YELLOW OWNER COPY (INITIAL): PINK