IREDELL COUNTY HEALTH DEPARTMENT

Statesville Phone TR 3-7271 Mooresville Phone MO 3-1271

PERMIT TO INSTALL SEPTIC TANK

Permit NO. Ce Morrow Permit Date Sept 7 1965

Owner Cross Roads Gpc. Address R 8 -

Installed By C Hoke Address R7


Location of Property Shell Sta Bradford x Rd.

Tank	Capacity	Length of Lines	Fixtures
Block ( )	1000 ( )	225' ( )	No. of Baths ( )
Precast X ( )	1250 ( )	250' ( )	Dishwasher ( )
	1500 ( )	Other 340 sq ft.	Garbage Grdr. ( )
	Other	1640 sq ft.	Other

NOTIFY HEALTH DEPARTMENT AT LEAST EIGHT HOURS BEFORE TANK IS TO BE INSPECTED.

Final Inspection 19 Approved ( ) Disapproved ( )

Remarks Repair to old layout - seems to be excess of water used.

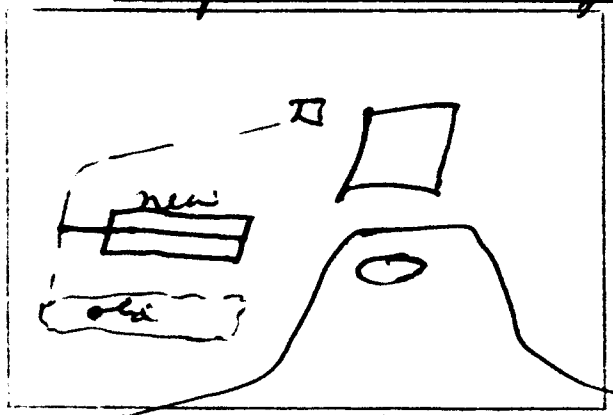

Sketch of Installation

Sanitarian