IREDELL COUNTY HEALTH DEPARTMENT

Statesville Office (704) 878-5305 Mooresville Office (704) 660-3625 PERMIT # 203092

IMPROVEMENT PERMIT / AUTHORIZATION TO CONSTRUCT / OPERATION PERMIT / EXISTING SYSTEM

PIN # 4704556428 ✓

APPLICANT: John Pimiento APPLICANT ADDRESS: [redacted] 148 Pebble Creek Dr.

SITE ADDRESS: 2133 Old Mountain Rd. PHONE: 704-437-2700 ALT. PHONE: N/A

SITE DIRECTIONS: Hwy 70W TR old Mtn Rd Property on Left beside Dollar General.

SUBDIVISION: N/A SECTION: N/A LOT # N/A LOT AREA: 0.59 acres DESIGN FLOW: 360gpd L.T.A.R.: Existing

Septic Tank Existing (gal) STB Date
Pump Tank (gal) PT Date
Pump Make Model Serial #
Nitrification Fields 1 # Lines 6x Linear Ft: 6x'
Trench Width 6x Max. Trench Bottom Depth 6x Gravel Depth 6x

☐ New System ☐ Repair ☐ Expansion System Type: I (II) III IV V VI
System Description: Conventional Bed
Repair System Description:
Maintenance Agreement Required: ☐ YES ☑ NO
☑ GRAVITY ☐ PRESSURE


☐ Residence No. Bedrooms
☑ Business No. Persons
☐ Other Daycare 3 employees 19 kids No. Employees 3
☐ Slab ☑ Crawl Space
☐ Basement w/plumbing ☐ Basement w/o plumbing

Water Supply: ☐ Private ☑ Public ☐ Community


Comments / Conditions:

System is sized to accommodate a Day Care with 3 Employees & 19 Kids ONLY; No Living Quarters are permitted in business.

INITIAL SITE SKETCH

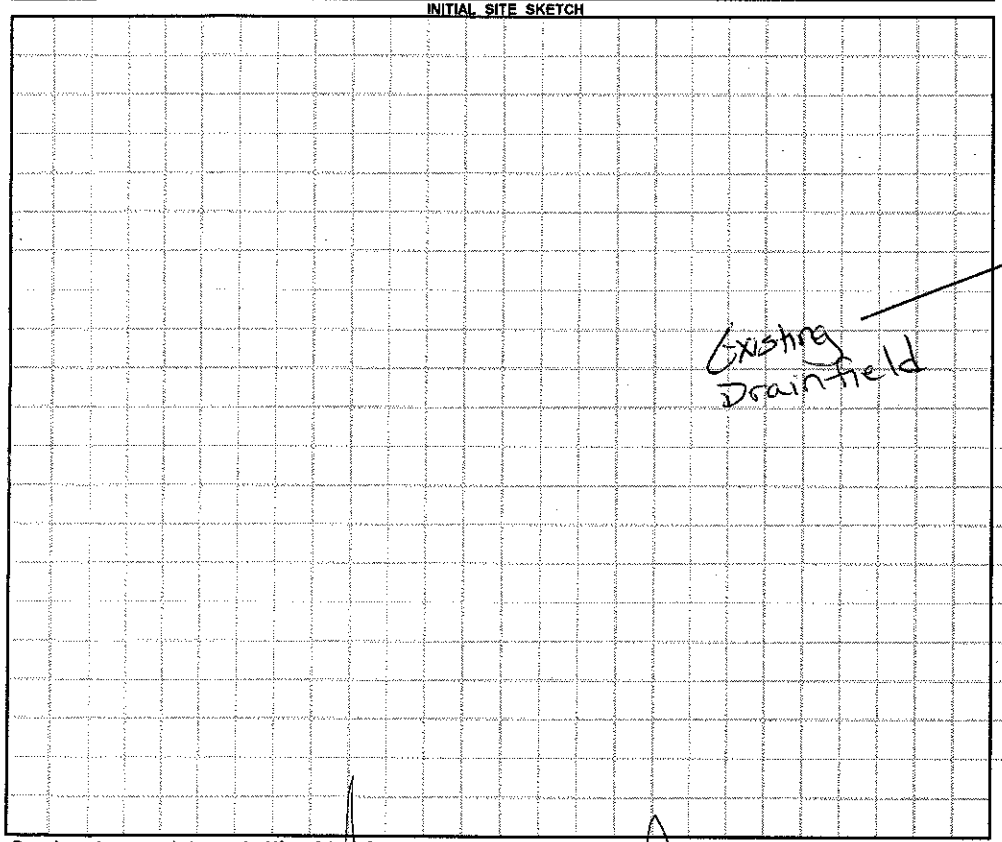

AS BUILT SKETCH

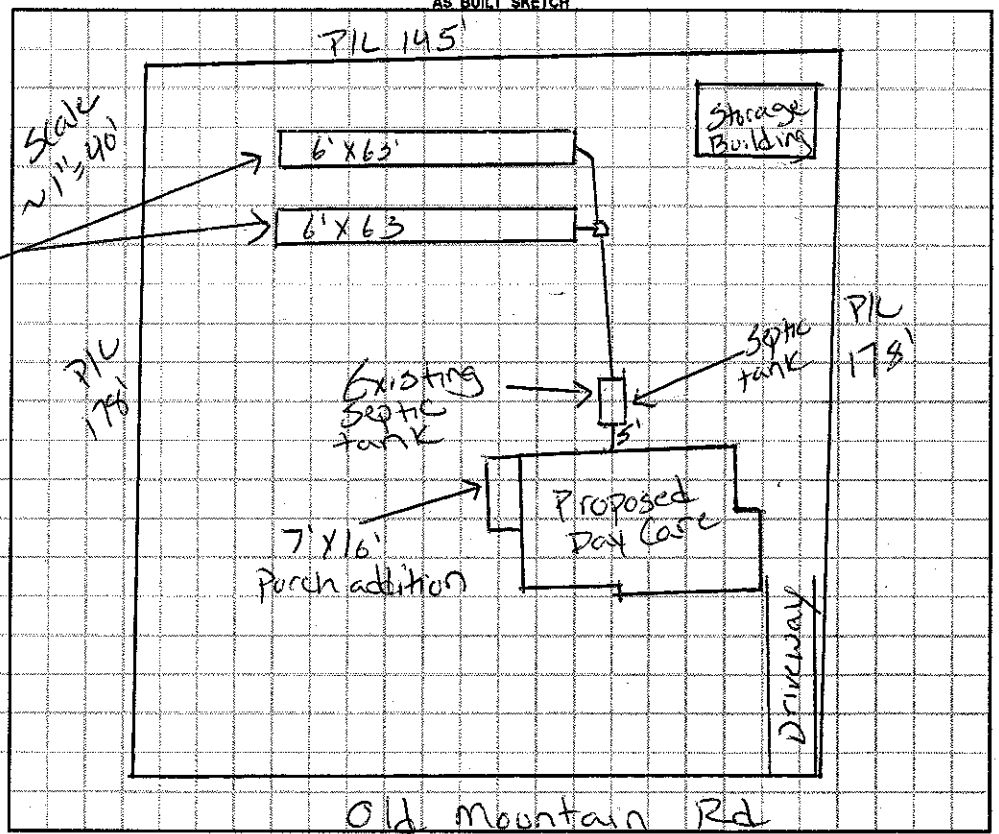

Permit can be suspended or revoked if any false information is supplied toward securing the permit / any unauthorized changes are made to the site / any unauthorized changes are made in the installation of the system. **CONTACT A LOCATOR SERVICE PRIOR TO ANY EXCAVATION**

☐ **IMPROVEMENT PERMIT** *with plat valid without expiration.* ☐ **IMPROVEMENT PERMIT** *with site plan valid for 60 mos.* ☐ **AUTHORIZATION TO CONSTRUCT** *valid for period equal to IMPROVEMENT PERMIT--not to exceed 60 mo.*

Owner / Applicant Signature: [signature] Date: 6-11-14 Installed by:

IMPROVEMENT PERMIT by: Date: OPERATION PERMIT by: Date:

AUTHORIZATION TO CONSTRUCT by: Date: Existing System Inspected by: [signature] Date: 6-11-14

Health Dept. Copy - WHITE Applicant (Final Approval) - YELLOW Applicant (Conditional Approval) - PINK