IREDELL COUNTY HEALTH DEPARTMENT

STATESVILLE 704-878-5305 MOORESVILLE 704-664-5281

IMPROVEMENT PERMIT / CERTIFICATE OF COMPLETION / OPERATION PERMIT / EXISTING SYSTEM INSPECTION

PROPERTY DESCRIPTION NO. 23812 DATE 6-17-96 TAX MAP NO. _____ Watershed: ☐ Yes ☐ No

OWNER OR CONTRACTOR West Iredell VFD PHONE: Business 911 Home _____

ADDRESS Oldmtn Rd

LOCATION I-40 West TR Oldmtn 1/2mi Rt SITE CLASS. PS DESIGN FLOW 360 L.T.A.R. .3

SUBDIVISION _____ BLOCK / SECTION _____ LOT _____ LOT AREA 3/4 acre

Septic Tank: 1500 Gallons; STB 1011 Date 8-19-91

Pump Tank: _____ Gallons; PT _____ Date _____

Pump Make: _____ Model _____ Serial No. _____

Nitrification Field: No Fields 1 Square Feet 1200 Linear Feet 400

No Lines 4 Trench Width 36" Max Trench Bottom Depth 36" Gravel Depth 12"

☐ New System ☑ Repair System Type: I. II. III. IV. V. VI

System Description: _____

Repair System Description: Conv. Gravity

Maintenance Agreement Required: ☐ Yes ☐ No

☐ House/Mod. Home No. Bedrooms ____

☐ Mobile Home No. Bathrooms ____

☐ Business No. Employees ____

☐ Other Volunteer Fire Dept

Water Supply: ☐ Individual ☐ Community ☐ Public


☐ Slab ☑ Crawl Space ☐ Basement w/plumbing ☐ Basement wo/plumbing

Comments:


Making addition To Ex. Building over Ex. S.T. system Having To Replace with NEW S.T. System

Comments:

INITIAL SITE SKETCH

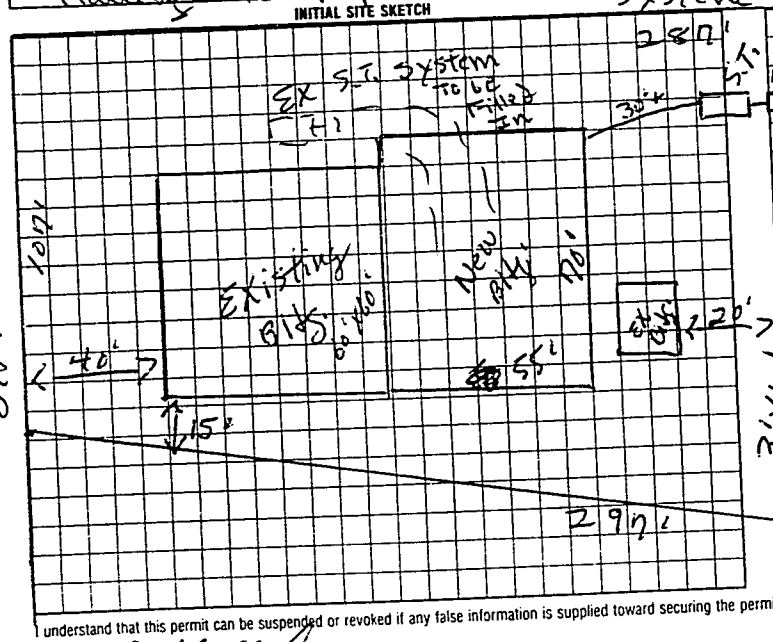

AS BUILT SKETCH

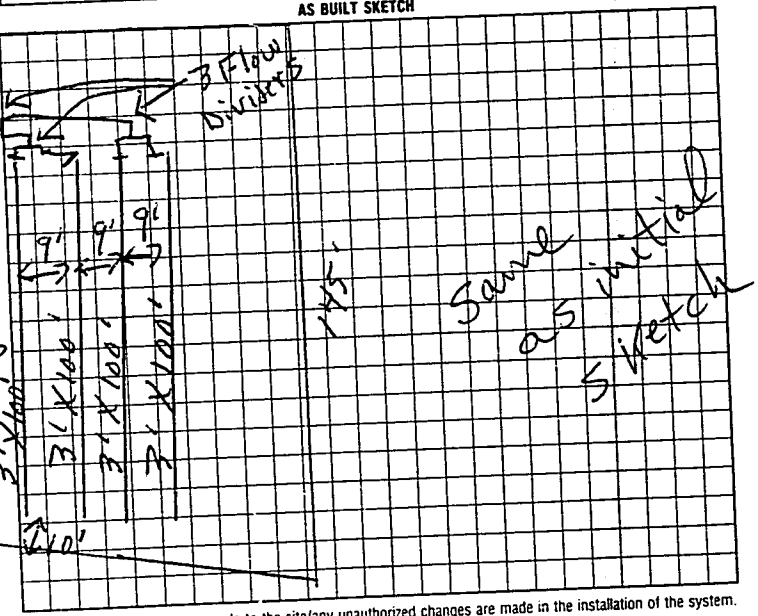

Oldmtn Rd

I understand that this permit can be suspended or revoked if any false information is supplied toward securing the permit/any unauthorized changes are made to the site/any unauthorized changes are made in the installation of the system.

Signed: Jeff M. Angel Installed by: Rick Shook date _____

Improvement Permit by: P.C. Moore date 6-17-96 Certificate of Completion by: P.C. Moore date 10-28-96

~~Existing System Inspection~~ Authorization to Count P.C. Moore date 6-17-96 Operation Permit by: _____ date _____

Expires 60 mon from issue

HEALTH DEPT. COPY WHITE INSPECTION COPY (FINAL) GREEN OWNER COPY (FINAL) YELLOW INSPECTION COPY (INITIAL) PINK OWNER COPY (INITIAL): GOLD

1122 00