IREDELL COUNTY HEALTH DEPARTMENT

Statesville Phone TR 3-7271 Mooresville Phone NO 3-1271

PERMIT TO INSTALL SEPTIC TANK

Permit NO. Fire sta. Permit Date Aug 30 1961

Owner Bradford X Rd. Fire Address Bradford X Rd

Installed By C Hoke Address R7


Location of Property on Right before Bradford X Rd

Tank	Capacity	Length of Lines	Fixtures
Block ( )	800 ( )	150' ( )	No. of Baths (2) 5 total
Precast (✓)	900 ( )	175' ( )	Dishwasher ( )
	1000 (✓)	200' ( )	Garbage Grdr. ( )
	1100 ( )	225' (✓)	~~Auto-Washer~~ ( )
Cash	1200 ( )	250' ( )	Other
	Other	Other	

NOTIFY HEALTH DEPARTMENT AT LEAST EIGHT HOURS BEFORE TANK IS TO BE INSPECTED.

Final Inspection Aug 30 1961 Approved (✓) ~~Disapproved~~ ( )

Remarks well 55'

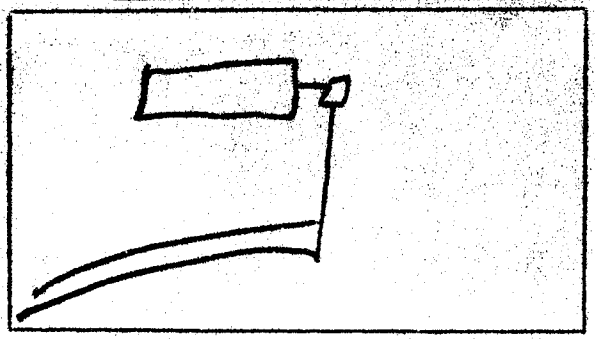

Sketch of Installation

RF

Sanitarian

✓