IREDELL COUNTY HEALTH DEPARTMENT

Statesville Phone TR 3-7271 Mooresville Phone NO 3-1271

PERMIT TO INSTALL SEPTIC TANK

Permit Date 3-21 1968

Permit No. _____

Owner WOW Camp 6417 Address "R" Statesville, N.C.

Installed By Sam Osteen Address Troutman, N.C.


Location of Property I-40, Rt on Mt Rd. 1st Block building on Rt before Bradford's Cross rd.

Tank		Capacity		Length of Lines		Fixtures	
Block	( )	1000	(✓)	225'	(✓)	No. of Baths	( )
Precast	( )	1250	( )	250'	( )	Dishwasher	( )
		1500	( )	Other _____		Garbage Grdr.	( )
		Other _____				Other _____	

NOTIFY HEALTH DEPARTMENT AT LEAST EIGHT HOURS BEFORE TANK IS TO BE INSPECTED.

Final Inspection 3-21 1968 Approved (✓) Disapproved ( )

Remarks Septic Installation not installed - not practical location due to location of bathroom

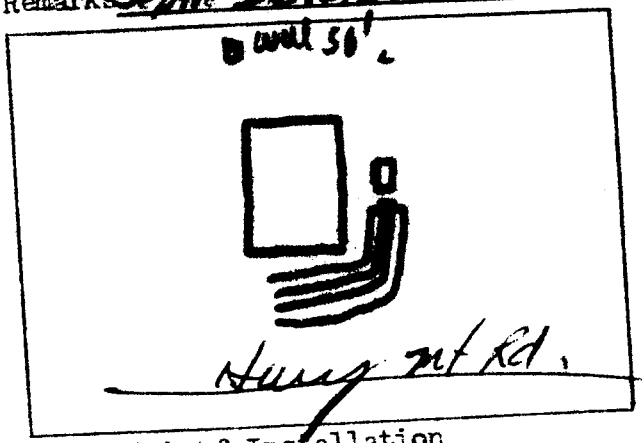

Sketch of Installation

Anthony D. Hutchinson R.S.
Sanitarian