IREDELL COUNTY HEALTH DEPARTMENT

Statesville Phone TR 3-7271 Mooresville Phone NO 3-1271

PERMIT TO INSTALL SEPTIC TANK

Permit NO. Fire sta. Permit Date Aug 30 1961

Owner Bradford X Rd. Fire Address Bradford X Rd

Installed By C Hoke Address R7


Location of Property on Right before Bradford X Rd

| Tank | Capacity | Length of Lines | Fixtures |
|---|---|---|---|
| Block ( ) | 800 ( ) | 150' ( ) | No. of Baths (2) 5 total |
| Precast (✓) | 900 ( ) | 175' ( ) | Dishwasher ( ) |
| | 1000 (✓) | 200' ( ) | Garbage Grdr. ( ) |
| | 1100 ( ) | 225' (✓) | ~~Auto-Washer~~ ( ) |
| Cash | 1200 ( ) | 250' ( ) | Other |
| | Other | Other | |

NOTIFY HEALTH DEPARTMENT AT LEAST EIGHT HOURS BEFORE TANK IS TO BE INSPECTED.

Final Inspection Aug 30 1961 Approved (✓) ~~Disapproved~~ ( )

Remarks well 55'

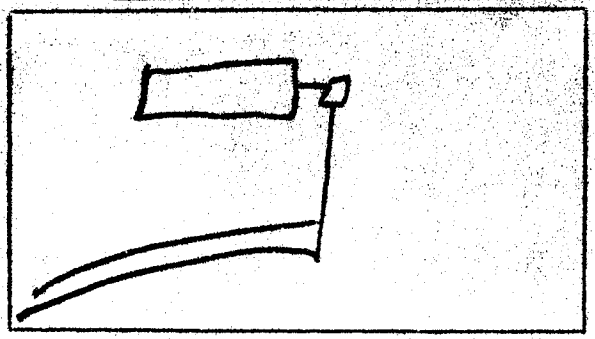

Sketch of Installation

RF

Sanitarian

✓