IREDELL COUNTY HEALTH DEPARTMENT

Statesville Phone TR 3-7271 Mooresville Phone NO 3-1271

PERMIT TO INSTALL SEPTIC TANK

Permit NO. — Permit Date 3.27 19[illegible]

Owner Charlie Brown Address R1 Statesville, N.C.

Installed By Wayne Craig Address Taylorsville R.C.


Location of Property I 40 W. 7½ on Old Rd. Building on Rt at Bradford Cross. (R-B Golf Building)

| Tank | | Capacity | | Length of Lines | | Fixtures | |
|---|---|---|---|---|---|---|---|
| Block | ( ) | 1000 | ( ) | 225' | ( ) | No. of Baths | ( ) |
| Precast | ( ) | 1250 | ( ) | 250' | ( ) | Dishwasher | ( ) |
| | | 1500 | (✓) | Other 1500 sq ft | | Garbage Grdr. | ( ) |
| | | Other | | | | Other | |

NOTIFY HEALTH DEPARTMENT AT LEAST EIGHT HOURS BEFORE TANK IS TO BE INSPECTED.

Final Inspection 3.28 1968 Approved (✓) Disapproved ( )

Remarks

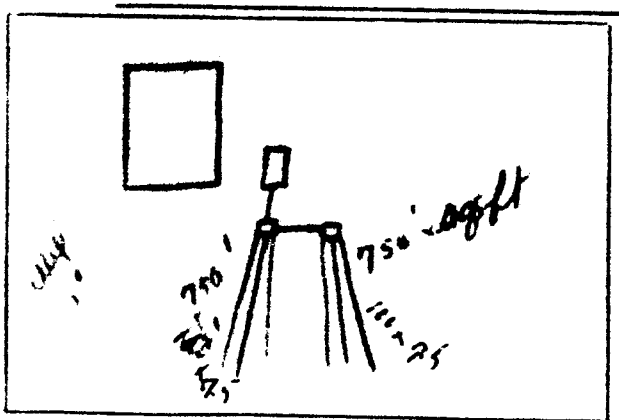


Sketch of Installation

Andrew L. Hutchins S.S.

Sanitarian