IREDELL COUNTY HEALTH DEPARTMENT - *ENVIRONMENTAL HEALTH* ☐ STATESVILLE OFFICE 704-878-5305 ☐ MOORESVILLE OFFICE 704-664-5281

IMPROVEMENT PERMIT / AUTHORIZATION TO CONSTRUCT / OPERATION PERMIT / EXISTING SYSTEM INSPECTION

PERMIT # Repair PIN # 4704-58-1923 DATE 12 November 10

OWNER Jeff Dellinger APPLICANT: PHONE: Home/Cell # (704) 880-5844 Business # (704) 872-4534

SITE ADDRESS 157 Brady Ln Stat. OWNER / APPLICANT ADDRESS

SITE DIRECTIONS Old mill. Turn onto Brady Ln. on Left just before pond

SUBDIVISION BLOCK / SECTION LOT # LOT AREA 1/2 ac. DESIGN FLOW 360 gpd L.T.A.R. 0.3 gpd/ft²

Septic Tank Exist. Gallons: STB Date

Pump Tank 1000 Gallons: PT 149 Date 1-26-11

Pump Make Zoeller Model N152 Serial #

No. Nitrification Fields: 1 No. Lines 96 Linear Feet 300

Trench Width 36" Max. Trench Bottom Depth 36" Gravel Depth NA

☐ New System ☑ Repair ☐ Expansion System Type I II (III) IV V VI

System Description:

Repair System Description: Pressure manifold - 25% Reduction

Maintenance Agreement Required ☐ YES ☑ NO

☐ GRAVITY ☑ PRESSURE

☑ Residence No. Bedrooms 3

☐ Business No. Persons

☐ Other No. Employees


☐ Slab ☐ Crawl Space

☑ Basement w/plumbing ☐ Basement w/o plumbing

Water Supply: ☐ Private ☑ Public ☐ Community

Comments / Conditions

INITIAL SITE SKETCH

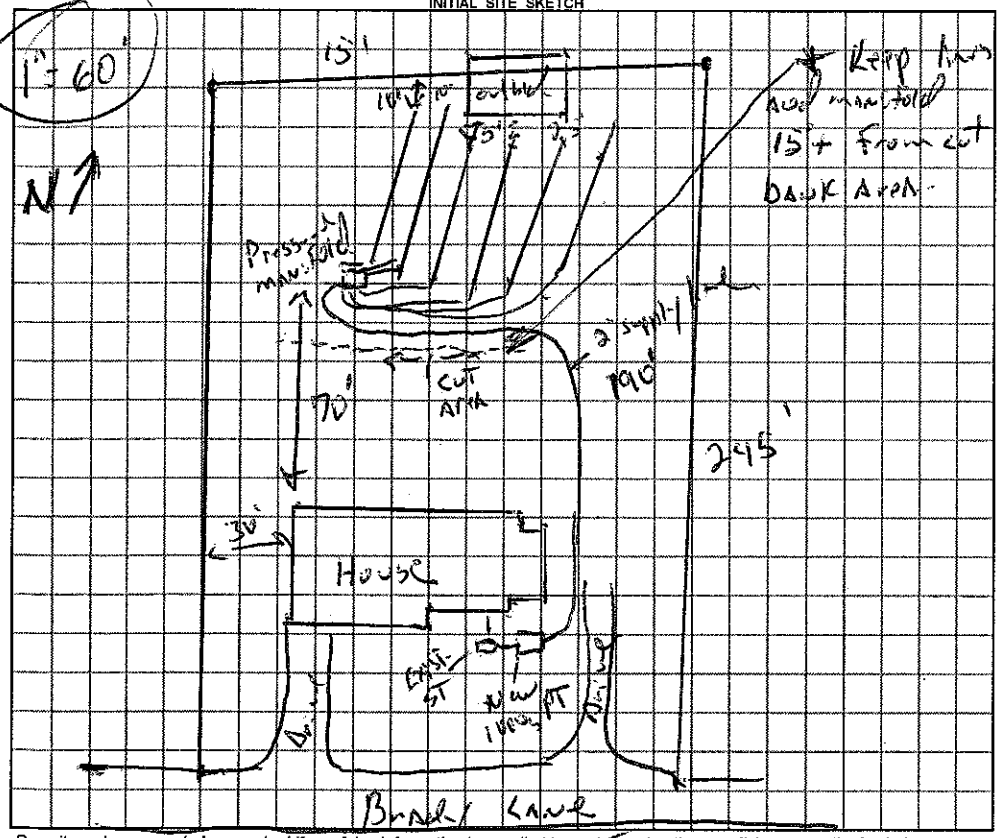

AS BUILT SKETCH

IQ 4W installed as Drawn on site sketch.

Permit can be suspended or revoked if any false information is supplied toward securing the permit / any unauthorized changes are made to the site / any unauthorized changes are made in the installation of the system.

☐ ***IMPROVEMENT PERMIT*** with plat valid without expiration. ☑ ***IMPROVEMENT PERMIT*** with plat valid without expiration. ☑ ***AUTHORIZATION TO CONSTRUCT*** valid for period equal to IMPROVEMENT PERMIT--not to exceed 60 mo.

Owner / Applicant Signature: Date 1-6-11 Installed by: Kevin Boles

IMPROVEMENT PERMIT by: REHS Date 16 Nov. 10 OPERATION PERMIT by: REHS Date 2 Sept 11

AUTHORIZATION TO CONSTRUCT by: REHS Date 16 Nov. 10 Existing System Inspected by: REHS Date

YOU SHOULD CONTACT A LOCATOR SERVICE PRIOR TO ANY EXCAVATION

White Copy – Environmental Health YELLOW COPY (Final) Owner / Applicant PINK COPY (Initial) Owner / Applicant