C1

IREDELL COUNTY HEALTH DEPARTMENT

STATESVILLE 704-878-5305 MOORESVILLE 704-664-5281

IMPROVEMENT PERMIT / AUTHORIZATION TO CONSTRUCT / OPERATION PERMIT / EXISTING SYSTEM INSPECTION

PERMIT# 143255 PIN# ~~4704-59-4163~~ 58-5921 DATE 6-14-07

OWNER OR APPLICANT CHARLES F. FEIMSTER PHONE: Business ______ Home 704-528-6105

ADDRESS 144 WINDING SHORE ROAD, TROUTMAN NC 28166-9786

LOCATION OLD MOUNTAIN ROAD WEST TO 'BRADY LANE', LOT AT END ON RIGHT

SUBDIVISION ______ BLOCK / SECTION ______ LOT ______ LOT AREA 1.62 ACRES SITE CLASS PS DESIGN FLOW 360 L.T.A.R. 0.30 GPD/FT2

Septic Tank: 1000 Gallons; STB 1012-1000 Date 5-11-07
Pump Tank: ______ Gallons; PT ______ Date ______
Pump Make: ______ Model ______ Serial No. ______
Nitrification Field: No Fields 1 Square Feet eq. to 1200 Linear Feet 300
No Lines FIVE Trench Width 36" Max Trench Bottom Depth 36" Gravel Depth N/A ☒ Gravity ☐ Pressure

☒ New System ☐ Repair ☐ Expansion System Type: I II III IV V VI
System Description: 25% REDUCTION, GRAVITY
Repair System Description: 25% REDUCTION, PUMP
Maintenance Agreement Required: ☐ Yes ☒ No

☒ House/Mod. Home ☐ Mobile Home ☐ Business ☐ Other
No. Bedrooms 3 No. Persons ______ No. Employees ______
☐ Slab ~~☐ Crawl Space~~ ☒ Basement w/plumbing ☐ Basement wo/plumbing


Water Supply: ☐ Individual ☒ Public ☐ Community

Comments./Conditions:
INSTALL 25% REDUCTION SYSTEM ON CONTOUR


Comments./Conditions:
P.L. 233.70'
ST Has marker
w/o F.Her tea

~SCALE: 1"=50'

INITIAL SITE SKETCH

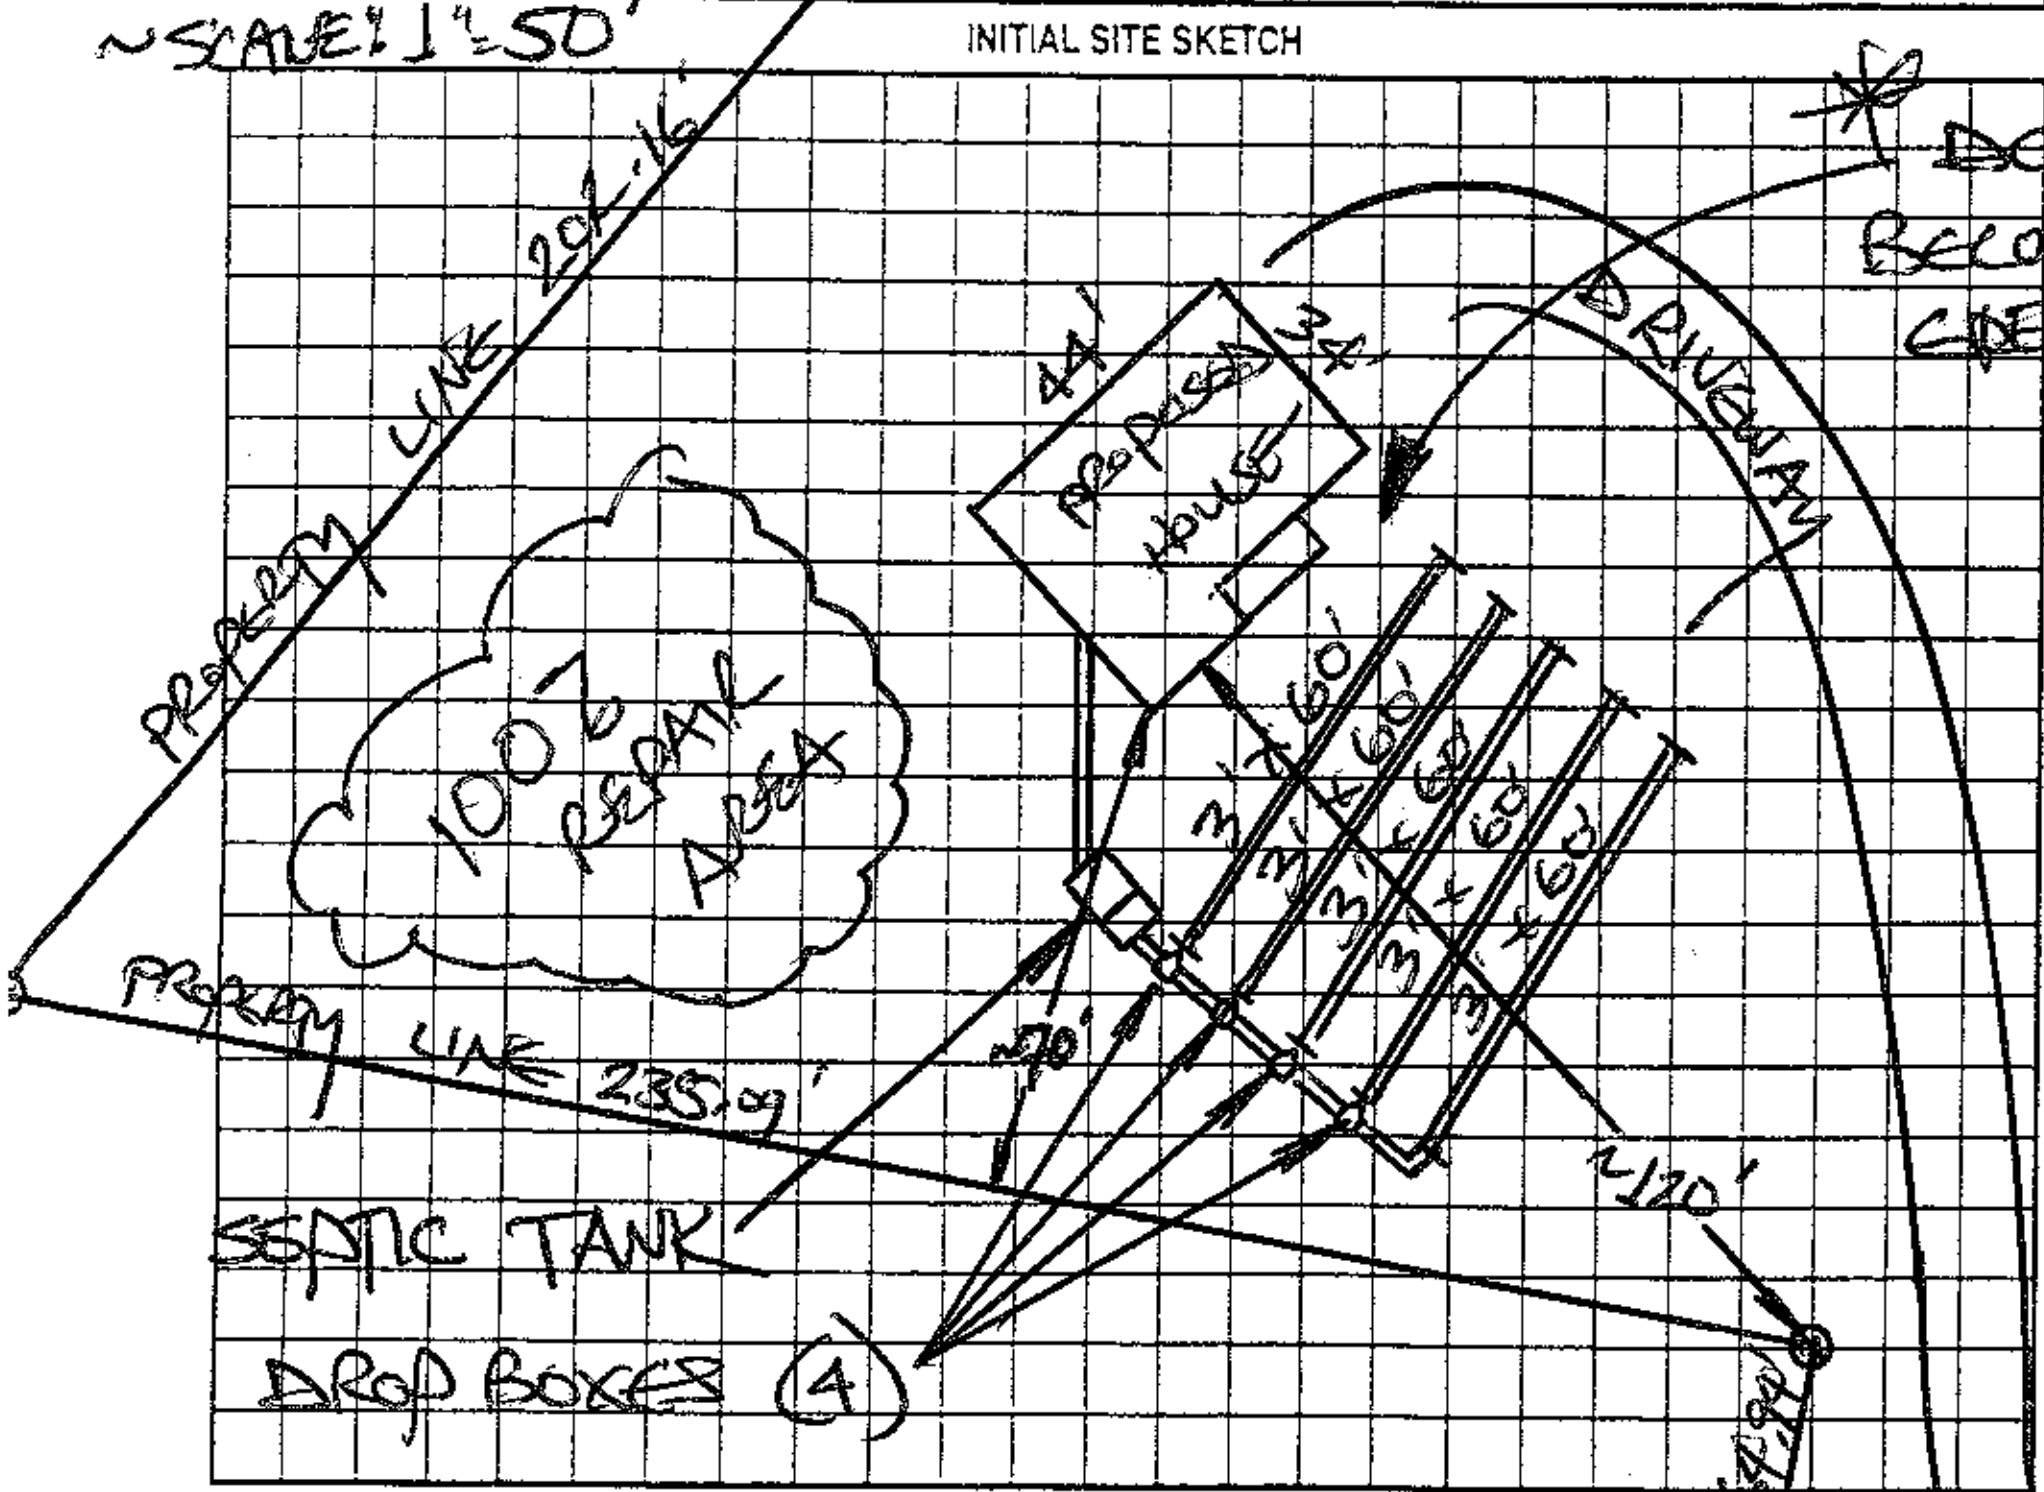

AS BUILT SKETCH

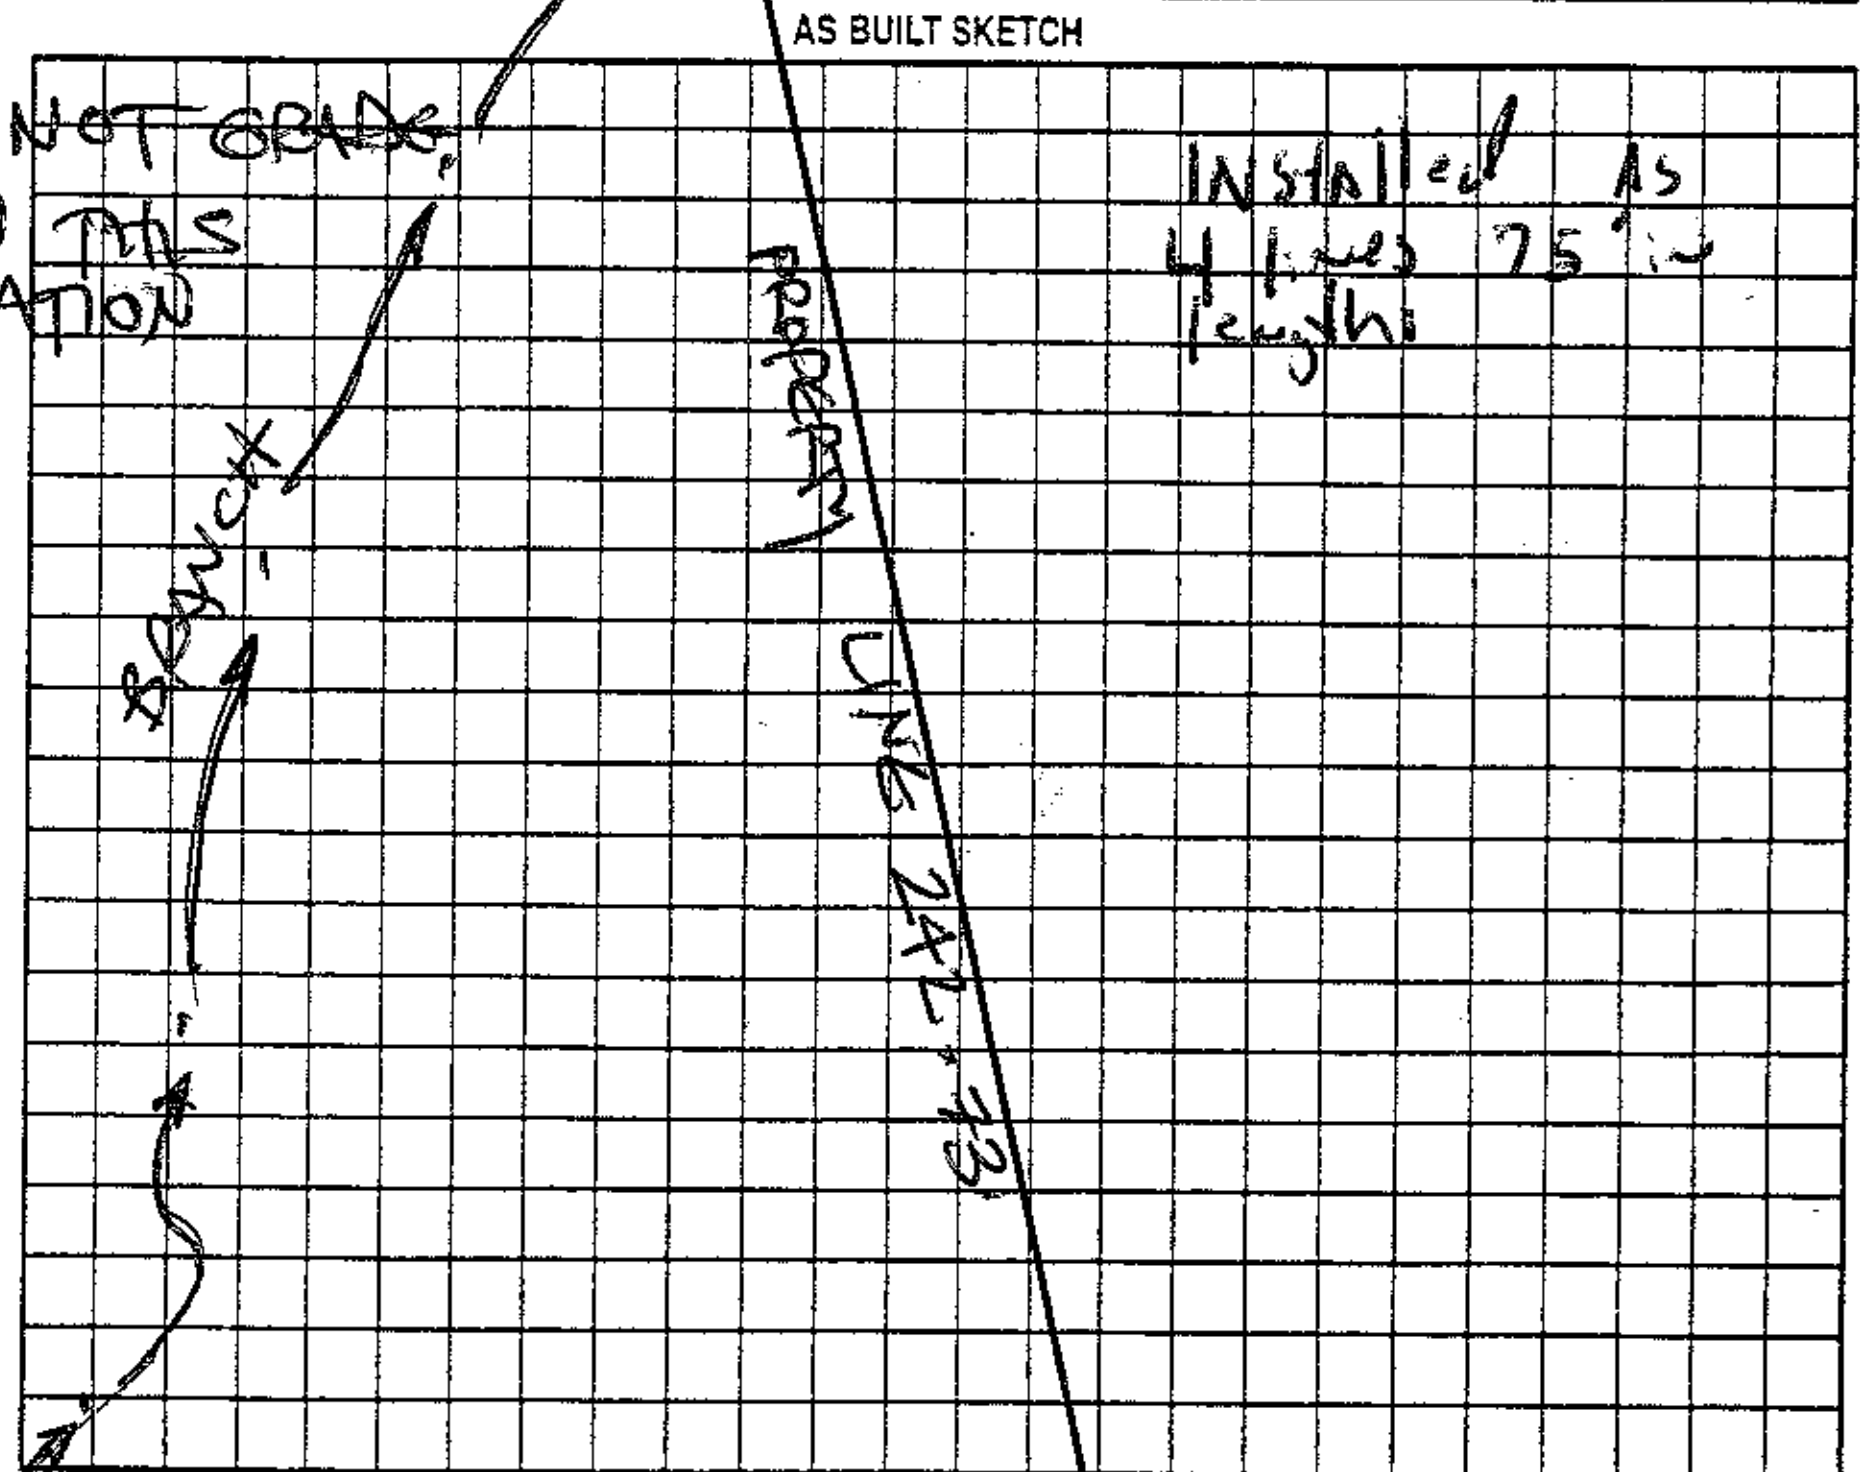

Permit can be suspended or revoked if any false information is supplied toward securing the permit/any unauthorized changes are made to the site/any unauthorized changes are made in the installation of the system. Improvement Permit with plat valid without expiration ☐ Improvement Permit with site plan valid for sixty months ☒ Authorization to Construct is valid for a period equal to that of Improvement Permit – not to exceed sixty months.

Signed: Charles Feimster date 6-14-07

Installed by: David Young

Improvement Permit by: STEVE HEDRICK date 6-14-07

Operation Permit by: [signature], R.S. date 19 Nov 07

Authorization to Construct by: STEVE HEDRICK date 6-14-07

Existing System Inspection by: ______ date ______

146.81' 47.28' BRADY LANE

HEALTH DEPT. COPY: WHITE OWNER COPY (FINAL): YELLOW OWNER COPY (INITIAL): PINK