IREDELL COUNTY HEALTH DEPARTMENT

STATESVILLE 704-878-5305 MOORESVILLE 704-664-5281 (I T)

IMPROVEMENT PERMIT / AUTHORIZATION TO CONSTRUCT / OPERATION PERMIT / EXISTING SYSTEM INSPECTION

PERMIT# 130307 PIN# 4709579111 DATE 8-17-05

OWNER OR CONTRACTOR Henery Davidson PHONE: Business Home 704-5725905

ADDRESS 3296 Hickory Hwy Statesville NC 28677

LOCATION I-40 (E) ONR (R) Island Ford Rd (L) Lippard Farm RD 227 Lippard Farm

SUBDIVISION BLOCK / SECTION LOT LOT AREA 1/4AC SITE CLASS. DESIGN FLOW 360 L.T.A.R. .5

Septic Tank: 1000 Gallons; STB UP 1000 Date 7-5-05

Pump Tank: Gallons; PT Date

Pump Make: Model Serial No.

Nitrification Field: No Fields Square Feet 1200 Linear Feet 400

No Lines 4 Trench Width 36" Max Trench Bottom Depth 36" Gravel Depth 12

☐ New System ☐ Repair System Type: I, II, III, IV, V, VI

System Description: Conv. Gravity

Repair System Description: Conv. Gravity

Maintenance Agreement Required: ☐ Yes ☑ No

☐ House/Mod. Home No. Bedrooms 3

☐ Mobile Home No. Bathrooms

☐ Business No. Employees

☐ Other


☐ Slab ☐ Crawl Space ☐ Basement w/plumbing ☐ Basement wo/plumbing

Water Supply: ☐ Individual ☐ Public ☐ Community

Comments/Conditions: Install on Contour. Maintain set backs.

Comments/Conditions: Septic Tank Must be installed by Isabel

INITIAL SITE SKETCH

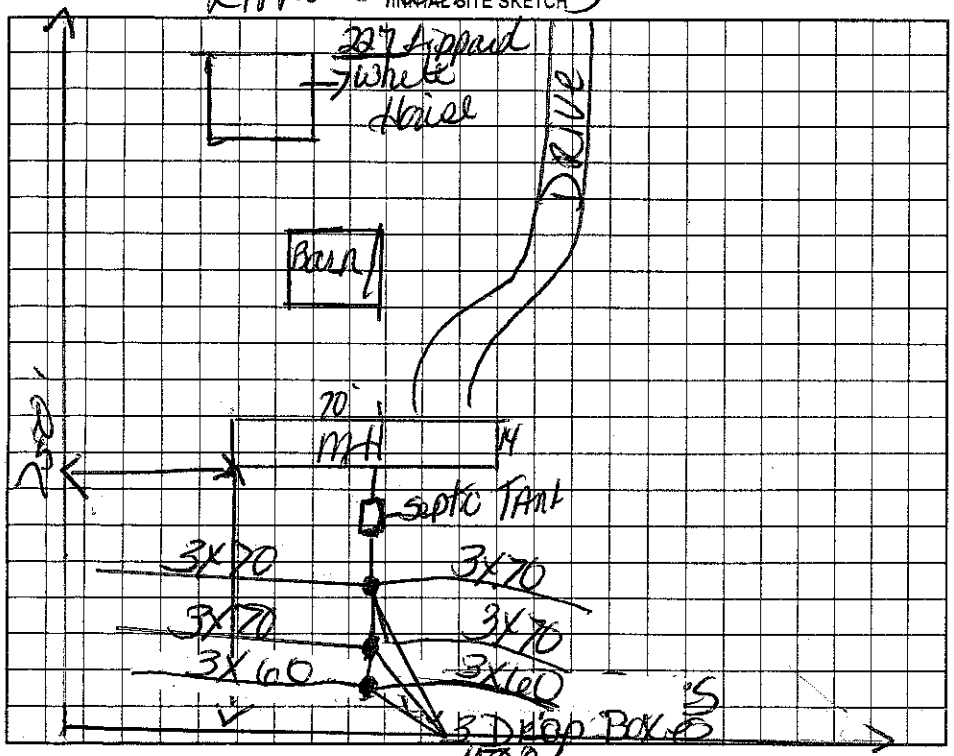

AS BUILT SKETCH

Permit can be suspended or revoked if any false information is supplied toward securing the permit/any unauthorized changes are made to the site/any unauthorized changes are made in the installation of the system. Improvement Permit with plat valid without expiration. Improvement Permit with site plan valid for sixty months. Authorization to Construct is valid for a period equal to that of Improvement Permit – not to exceed sixty months.

Signed: Henery Davidson date

Improvement Permit by: Kelly Cook date 8-17-05

Authorization to Construct by: Kelly Cook date 8-17-05

Installed by: Danny Isabel

Operation Permit by: Kelly Cook date 12-1-05

Existing System Inspection by: date

HEALTH DEPT. COPY: WHITE OWNER COPY (FINAL): YELLOW OWNER COPY (INITIAL): PINK