IREDELL COUNTY HEALTH DEPARTMENT

STATESVILLE 704-878-5305 MOORESVILLE 704-664-5281

IMPROVEMENT PERMIT / AUTHORIZATION TO CONSTRUCT / OPERATION PERMIT / EXISTING SYSTEM INSPECTION

PERMIT# 146461 PIN# 4704-63-6966 DATE 7 December 07

OWNER OR APPLICANT Quality Car Care, Inc. PHONE: Business 704-902-7678 Home 704-876-0164

ADDRESS 140 Cooper Drive, Statesville

LOCATION N/40W Turn onto Old Mtn. Rd. on Rt. Corner of Cooper + Old Mtn. Rd.

SUBDIVISION BLOCK / SECTION LOT LOT AREA 3.55Ac. SITE CLASS. P3 DESIGN FLOW 100gpd L.T.A.R. 0.3gpd/ft²

Septic Tank: 1000g Gallons: STB 1012 Date 3-10-08

Pump Tank: Gallons: PT Date

Pump Make: Model Serial No.

Nitrification Field: No Fields 1 Square Feet 340 Linear Feet 85

No Lines 1 Trench Width 36" Max Trench Bottom Depth 36 Gravel Depth NA

☑ New System ☐ Repair ☐ Expansion System Type: I II III IV V VI

System Description: 25% Reduction

Repair System Description: 25% Reduction

Maintenance Agreement Required: ☐ Yes ☐ No

☐ House/Mod. Home No. Bedrooms

☐ Mobile Home No. Persons

☑ Business No. Employees 3

☐ Other Auto Repair Shop

Water Supply: ☐ Individual ☑ Public ☐ Community

☐ Gravity ☐ Pressure ☑ Slab ☐ Crawl Space ☐ Basement w/plumbing ☐ Basement wo/plumbing

Comments:/Conditions:

Follow contour / Have Setback requirements.

No floor drains in Vehicle Service Area.


No industrial process wastewater in system.

Comments:/Conditions: Off-site Fill in system.

INITIAL SITE SKETCH

Please see Attached Layout

AS BUILT SKETCH

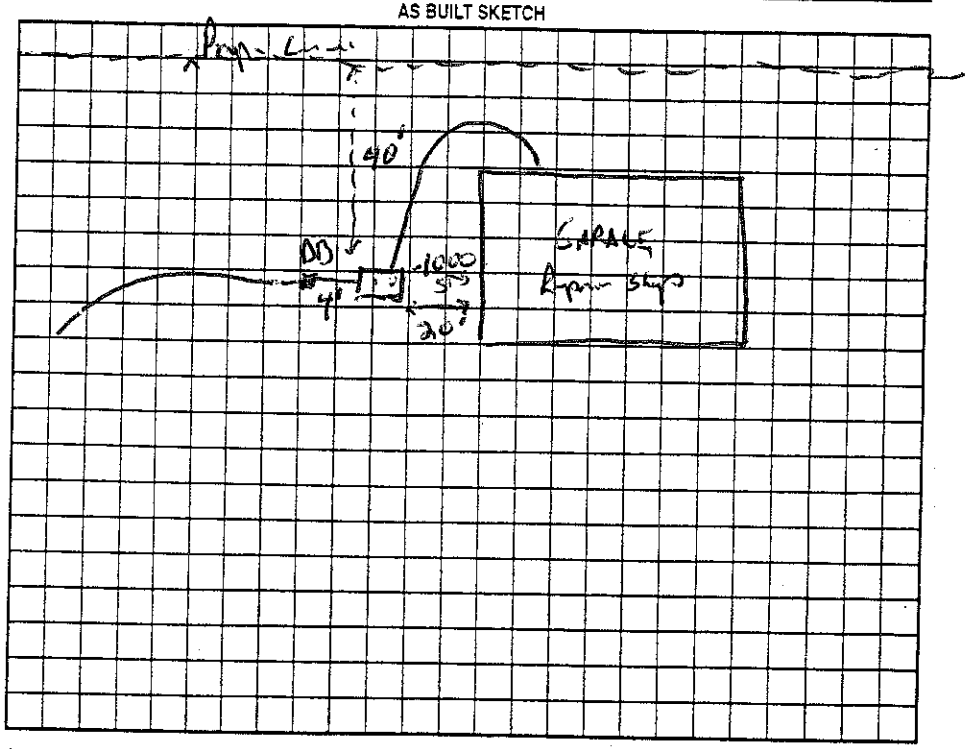

Permit can be suspended or revoked if any false information is supplied toward securing the permit/any unauthorized changes are made to the site/any unauthorized changes are made in the installation of the system. Improvement Permit with plat valid without expiration ☐ Improvement Permit with site plan valid for sixty months ☑ Authorization to Construct is valid for a period equal to that of Improvement Permit – not to exceed sixty months.

Signed: date

Improvement Permit by: , R.S. date 10 Dec. 07


Authorization to Construct by: , R.S. date 10 Dec. 07

Installed by: Ground Breaking

Operation Permit by: , R.S. date 18 September 08

Existing System Inspection by: date

HEALTH DEPT. COPY: WHITE OWNER COPY (FINAL): YELLOW OWNER COPY (INITIAL): PINK

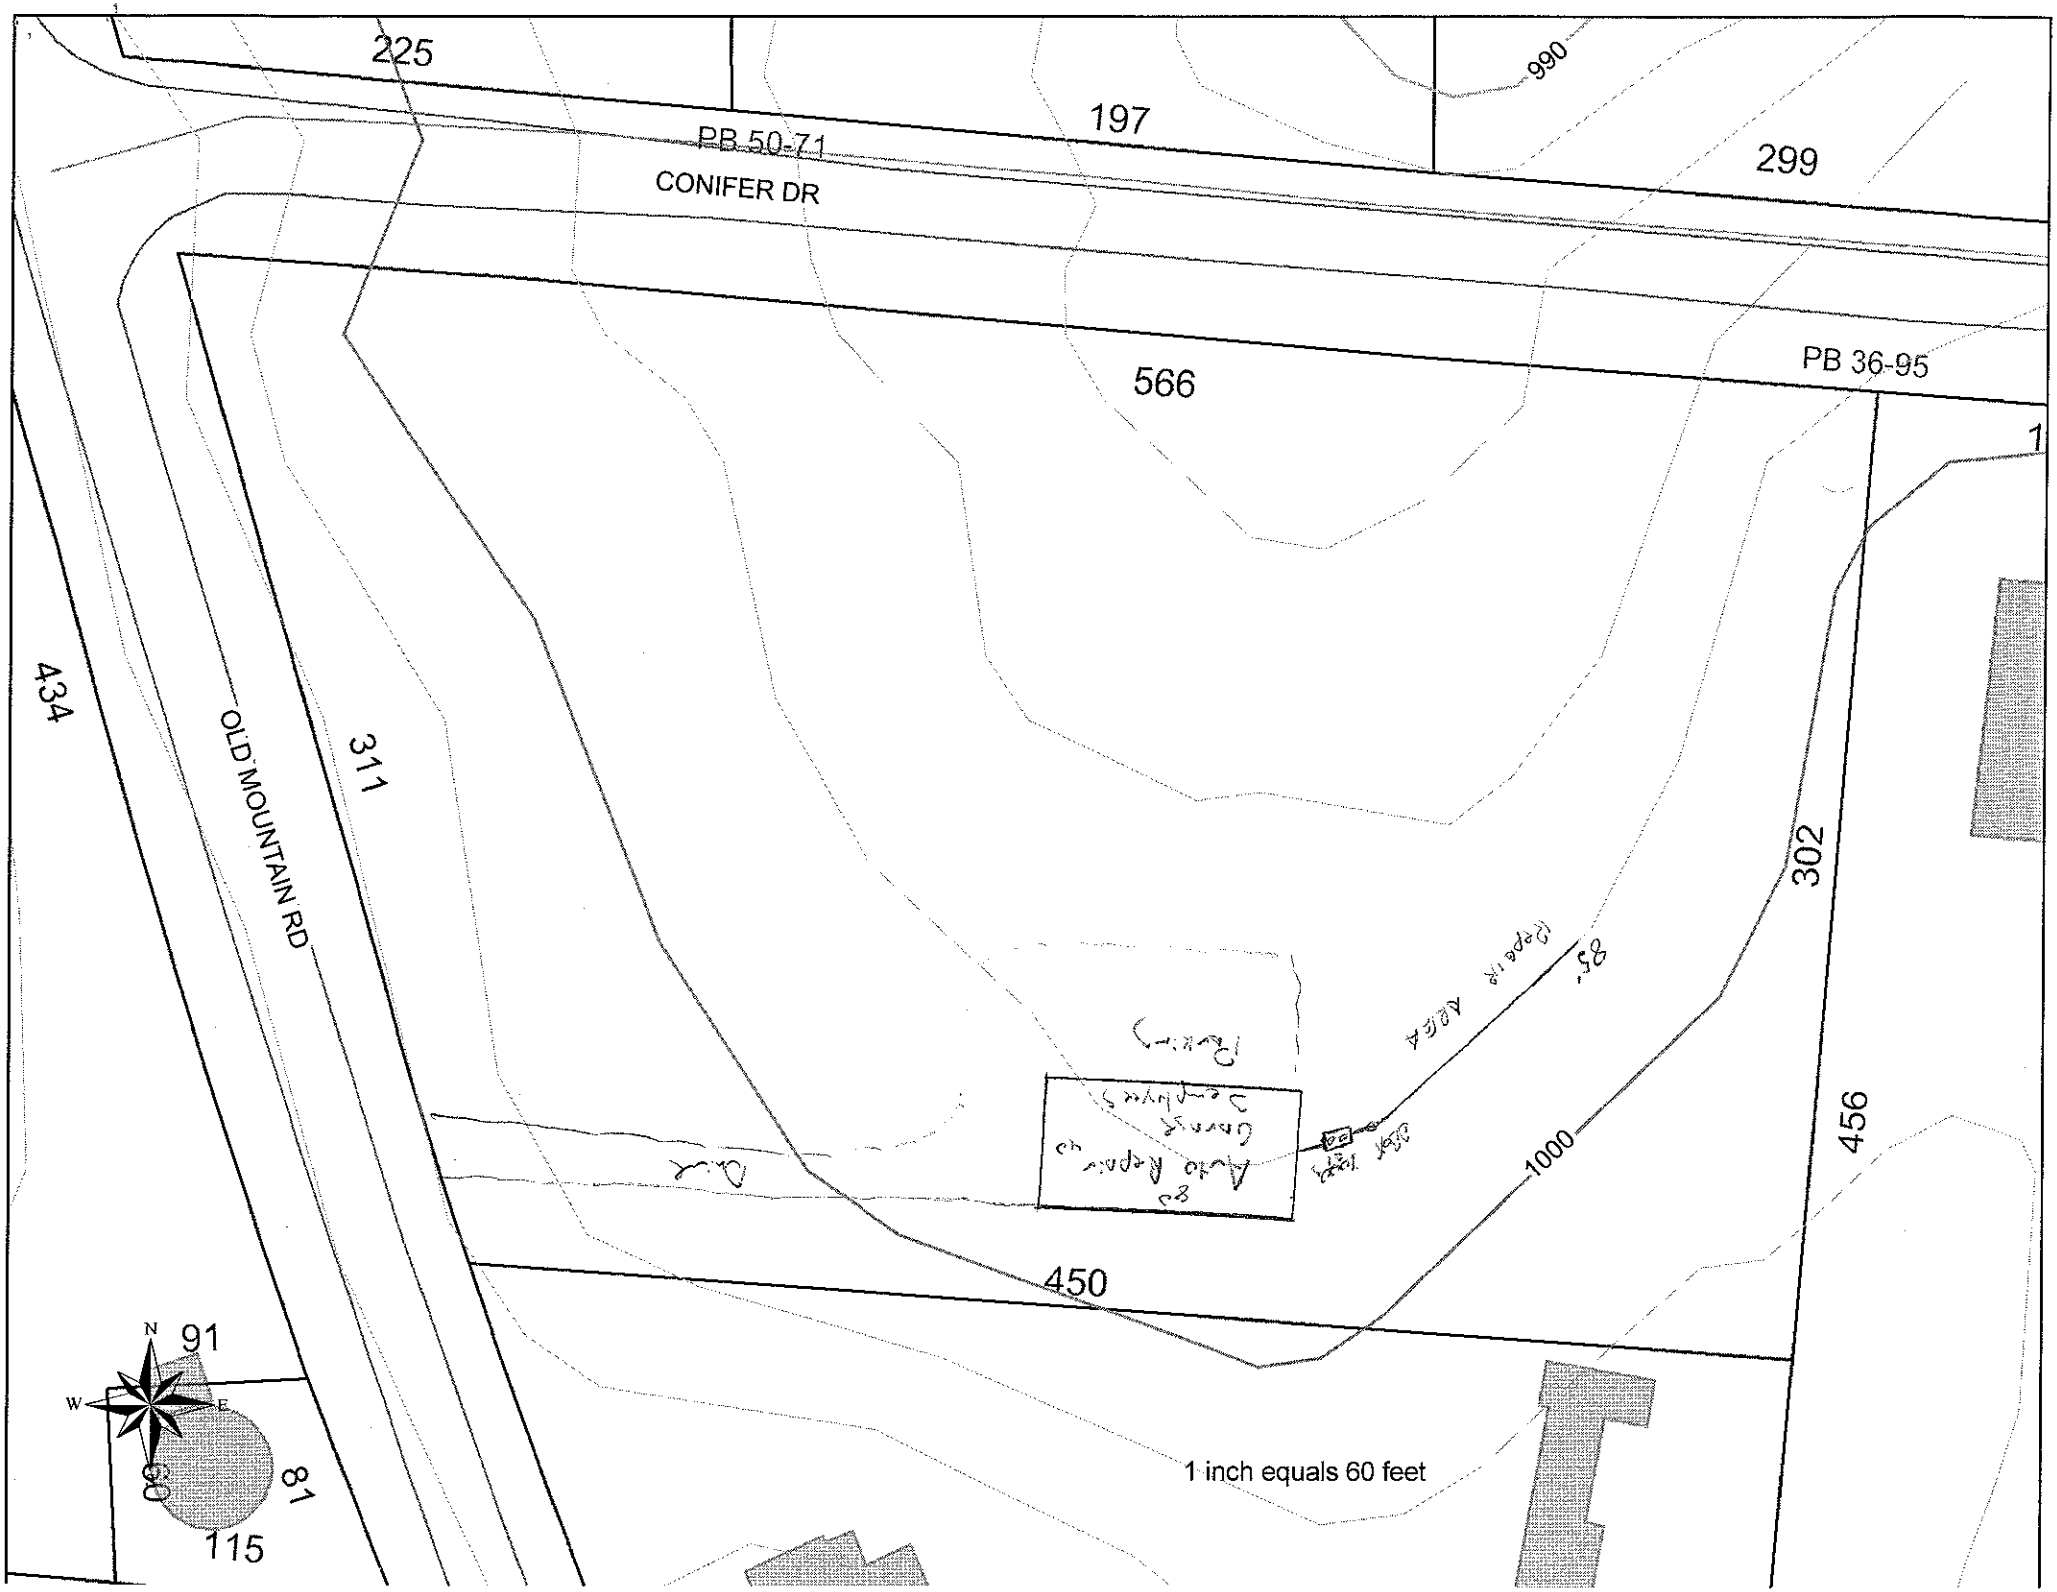
225
197
990
299
PB 50-71
CONIFER DR
566
PB 36-95
434
OLD MOUNTAIN RD
311
302
456
1000
450
91
81
115
N
W
E
1 inch equals 60 feet