IREDELL COUNTY HEALTH DEPARTMENT

STATESVILLE 704-878-5305 ✓ MOORESVILLE 704-664-5281

IMPROVEMENT PERMIT / AUTHORIZATION TO CONSTRUCT / OPERATION PERMIT / EXISTING SYSTEM INSPECTION

PERMIT# 10142620 PIN# 4704 63 9743 DATE 8/7/01

OWNER OR CONTRACTOR Imperial Services Inc. PHONE: Business 704-660-1441 Home

ADDRESS 516 D River Hwy Ste 273 Mooresville, NC 28117

LOCATION Conifer Dr., 40W TR OMR TR Conifer to Left on ® before Auto Care

SUBDIVISION N/A BLOCK / SECTION LOT LOT AREA ~1.19 AC SITE CLASS PS DESIGN FLOW 100GPD L.T.A.R. .3

Septic Tank: 1000 Gallons: STB 1007 Date 9-13-01
Pump Tank: Gallons: PT Date
Pump Make: Model Serial No.
Nitrification Field: No Fields 1 Square Feet 360 Linear Feet 120
No Lines 2@60' Trench Width 3' Max Trench Bottom Depth 3'+ Gravel Depth 12"

☒ New System ☐ Repair System Type: I, II, III, IV, V, VI
System Description: GRAVITY - CONVENTIONAL
Repair System Description: SAME
Maintenance Agreement Required: ☐ Yes ☒ No

☐ House/Mod. Home No. Bedrooms
☐ Mobile Home No. Bathrooms
☒ Business No. Employees 3
☐ Other

☒ Slab ☐ Crawl Space ☐ Basement w/plumbing ☐ Basement wo/plumbing


Water Supply: ☐ Individual ☒ Public ☐ Community W.T.R.C.O.G.U.

Comments/Conditions: All plumbing is not run very shallow a Pump Tank and Pump will be necessary.


Comments/Conditions: - Septic Tank Marker Installed
- Polylok Filter Installed
- Installed as shown

(1" = 40')

INITIAL SITE SKETCH

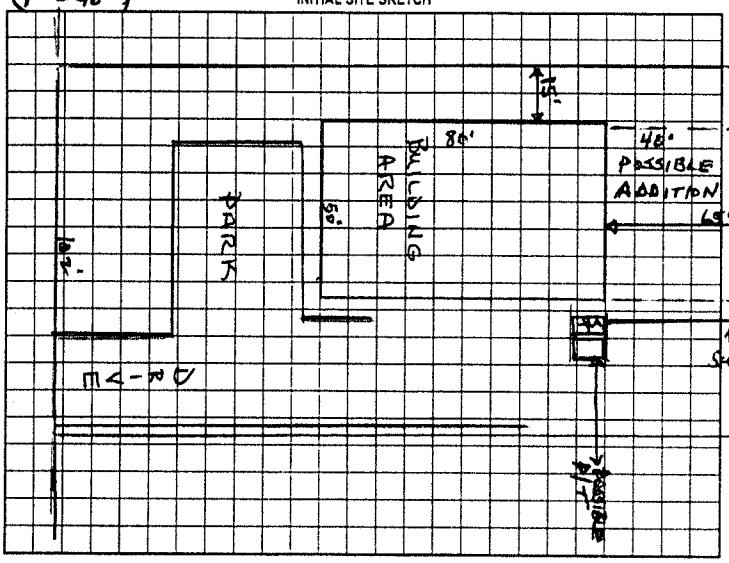

AS BUILT SKETCH

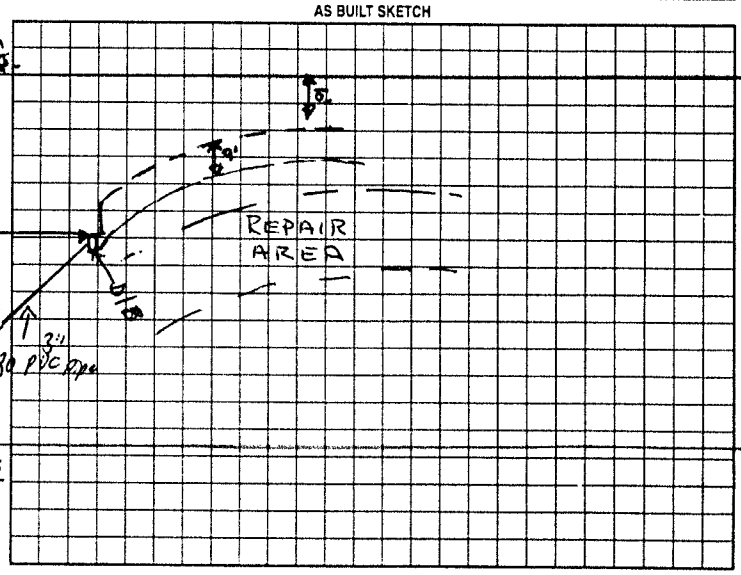

Permit can be suspended or revoked if any false information is supplied toward securing the permit/any unauthorized changes are made to the site/any unauthorized changes are made in the installation of the system. Improvement Permit with plat valid without expiration. Improvement Permit with site plan valid for sixty months. Authorization to Construct is valid for a period equal to that of Improvement Permit - not to exceed sixty months.

Signed: * Rodney A Gibson date 8/21/01 Installed by: James Hooker

Improvement Permit by: Wesley Sparks RS date 8/7/01 Operation Permit by: William C Johnson date 10/29/01

Authorization to Construct by: Wesley Sparks RS date 8/7/01 Existing System Inspection by: date

HEALTH DEPT COPY WHITE OWNER COPY (FINAL) YELLOW OWNER COPY (INITIAL) PINK