IREDELL COUNTY HEALTH DEPARTMENT

STATESVILLE 704-878-5305 MOORESVILLE 704-664-5281

IMPROVEMENT PERMIT / AUTHORIZATION TO CONSTRUCT / OPERATION PERMIT / EXISTING SYSTEM INSPECTION

PERMIT # 157889 PIN # 4704-65-3291 DATE 24 August 09

OWNER or APPLICANT Richard & Sally ~~Stanton~~ Higby PHONE: Business 704-902-7305 Home:

OWNER or APPLICANT ADDRESS 187 Ashley Acres Rd, Statesville, N.C.

LOCATION / DIRECTIONS Old Mtn. Rd. from Island Ford Rd. - on Left past Fire Dept.

SUBDIVISION BLOCK / SECTION LOT # LOT AREA DESIGN FLOW 360 g.p.d. L.T.A.R. 0.3 g/ft²/d

Septic Tank 1000 Gallons: STB Date

Pump Tank Gallons: P T Date

Pump Make Model Serial #

Nitrification Field No Fields 1 No Lines 4 Linear Feet 300

Trench Width 36" Max. Trench Bottom Depth 36" Gravel Depth PA

☑ New System ☐ Repair ☐ Expansion System Type I II III IV V VI

System Description: 25% Reduction System

Repair System Description: 25% Reduction System

Maintenance Agreement Required ☐ YES ☑ NO

☑ GRAVITY ☐ PRESSURE

☑ Residence No. Bedrooms 3

☐ Business No. Persons

☐ Other No. Employees

☐ Slab ☑ Crawl Space

☐ Basement w/plumbing ☐ Basement w/o plumbing

Water Supply: ☐ Private ☑ Public ☐ Community

Comments / Conditions: Follow contour / Observe all setback requirements. /

Comments / Conditions

INITIAL SITE SKETCH

Please see Attached site plan and site sketch.

AS BUILT SKETCH

The proposed garage addition does not appear to impact the existing septic system.

**NOTE:

R.S.

Date: 27 August 09

ICHD-Environmental Health Division

Permit can be suspended or revoked if any false information is supplied toward securing the permit / any unauthorized changes are made to the site / any unauthorized changes are made in the installation of the system.

☐ *IMPROVEMENT PERMIT w / plat valid without expiration.* ☑ *IMPROVEMENT PERMIT w / site plan valid for 60 mos.* ☑ *AUTHORIZATION TO CONSTRUCT valid for period equal to IMPROVEMENT PERMIT-not to exceed 60 mo.*

Owner / Applicant Signature: Date 8-24-09

Improvement Permit by: , R.S. Date 24 Aug. 09

Authorzation to Construct by: , R.S. Date 24 Aug. 09

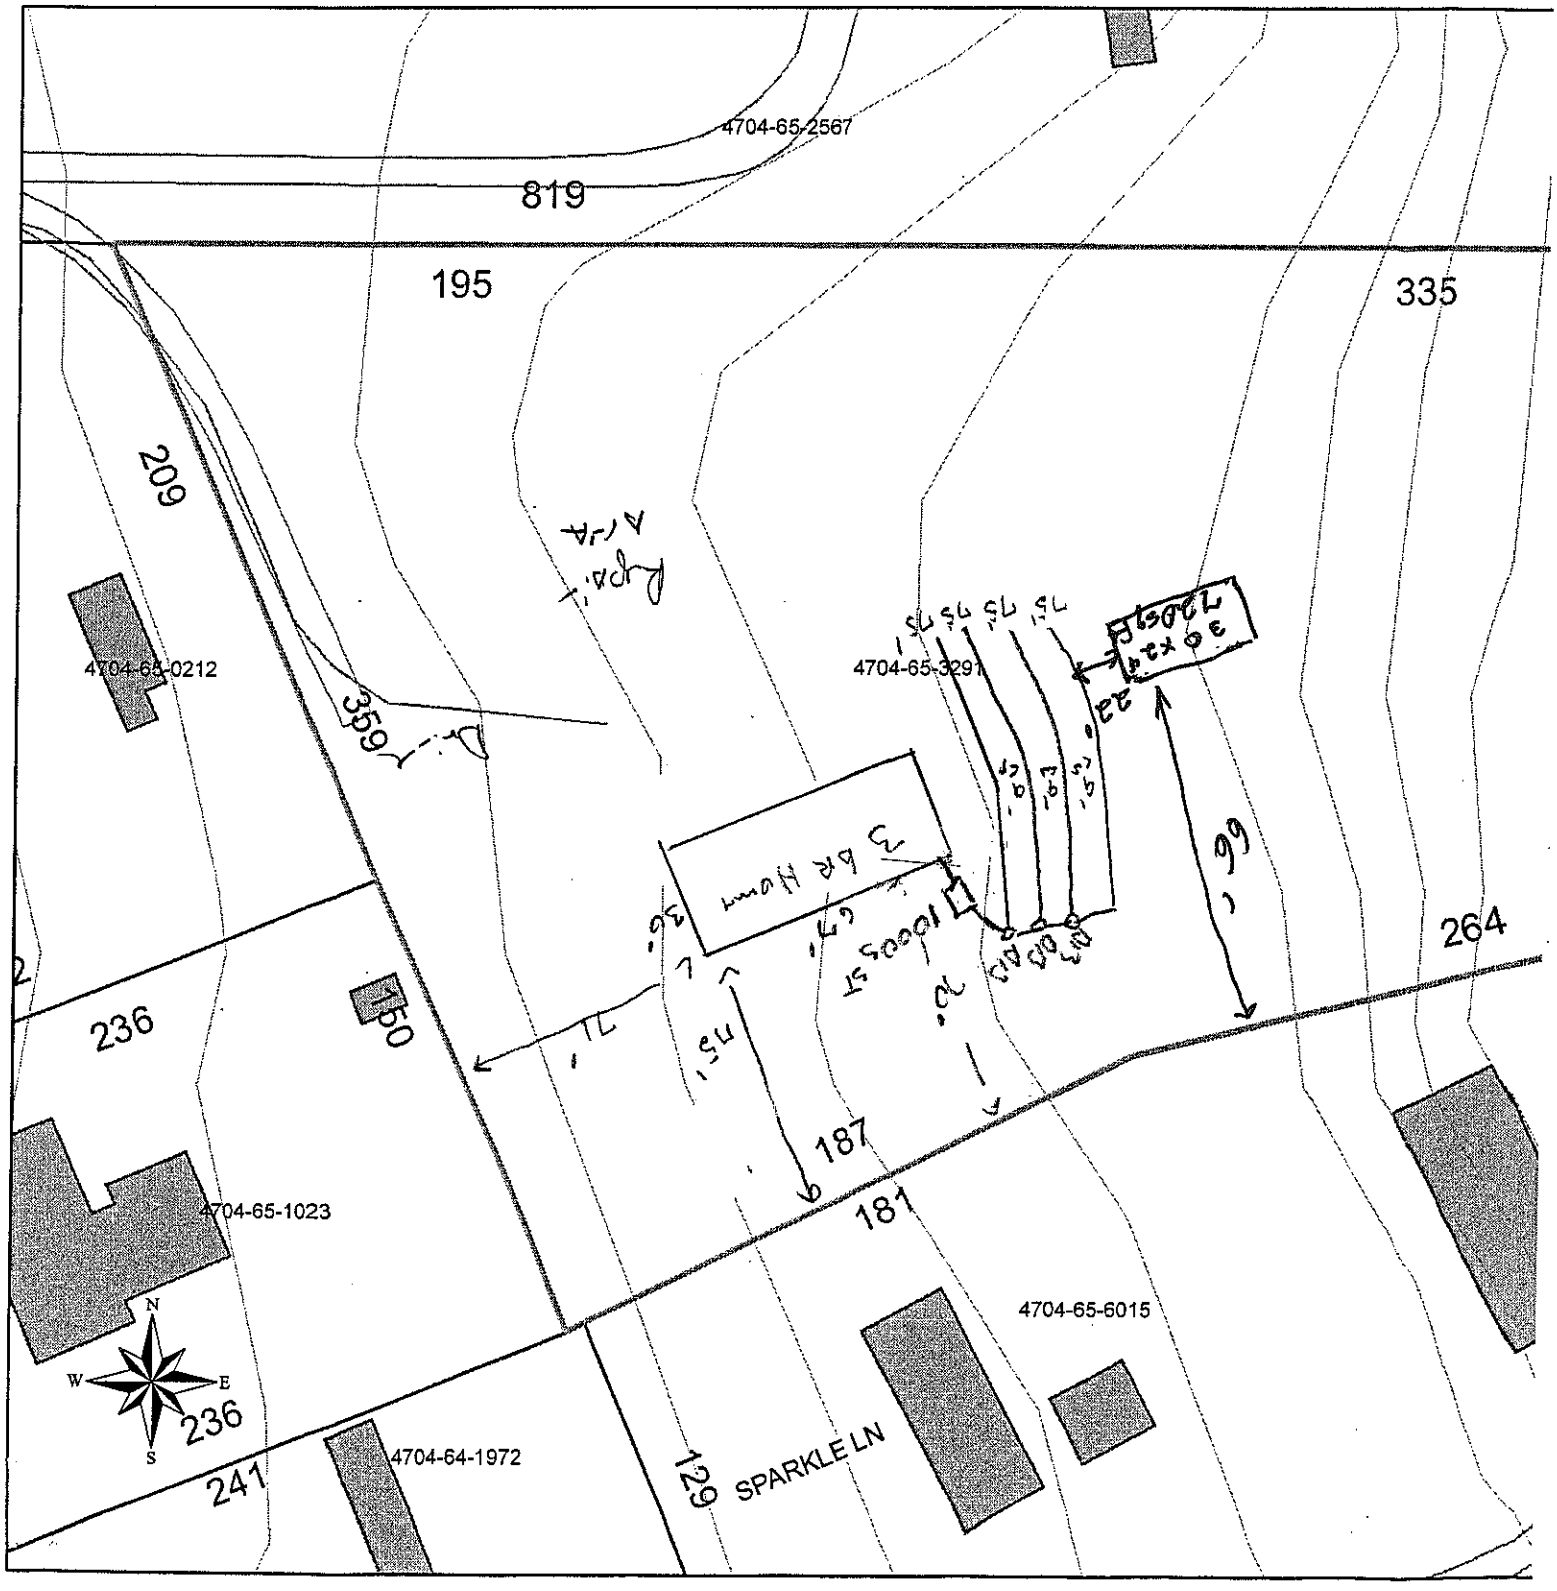
YOU SHOULD CONTACT A LOCATOR SERVICE PRIOR TO ANY EXCAVATION.

Installed by:

Operation Permit by: Date:

Existing System Inspected by: Date:

WHITE COPY Environmental Health YELLOW COPY (Final) Owner / Applicant PINK COPY (Initial) Owner / Applicant


4704-65-2567
819
195
335
209
4704-65-0212
359
4704-65-3291
3 BR Home
264
236
150
71'
187
181
4704-65-1023
4704-65-6015
N
W
E
S
236
241
4704-64-1972
126
SPARKLE LN