IREDELL COUNTY HEALTH DEPARTMENT

Statesville Phone TR 3-7271 Mooresville Phone No. 664-5281

PERMIT TO INSTALL SEPTIC TANK

Permit No. _____ Permit Date 4-13 1973

Owner Charles Brown Address Statesville N.C.

Installed By Alexander Septic Tank Co Address Stony Point N.C.


Location of Property Hickory Hwy to Old Mountain Rd
I.R. then T.L. at Beaulah Baptist Church.
4th house on L.

Tank		Capacity		Length of Lines		Fixtures	
Block	( )	1000	(✓)	225'	( )	No. of Baths	(2)
Precast	(✓)	1250	( )	250'	( )	Dishwasher	( )
		1500	( )	Other 300		Garbage Grdr.	( )
		Other				Other	

NOTIFY HEALTH DEPARTMENT AT LEAST EIGHT HOURS BEFORE TANK IS TO BE INSPECTED.

Final Inspection 4-13 1973 Approved (✓) Disapproved ( )

Remarks Well over 50' away

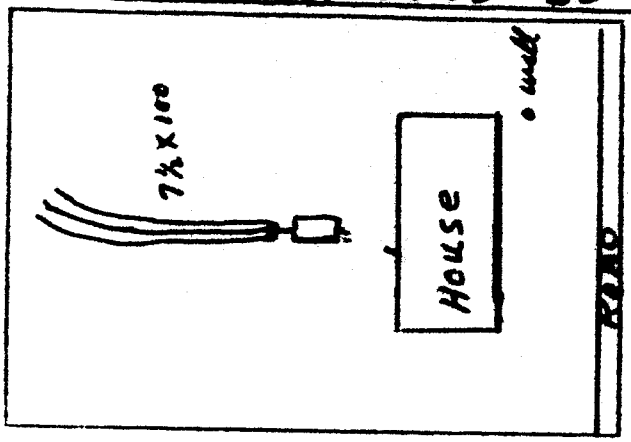

Sketch of Installation

E. A. Stevenson
Sanitarian