ICHD - ENVIRONMENTAL HEALTH DIVISION

Statesville Office (704) 878-5305 x3456 | Mooresville Office (704) 660-3625

BCW

PERMIT : OSWP 2024-64048

SEPTIC: IMPROVEMENT PERMIT / AUTHORIZATION TO CONSTRUCT / OPERATION PERMIT / EXISTING SYSTEM

PIN # 4704-70-94663

APPLICANT/OWNER: Jeanie Lentz | APPLICANT ADDRESS: 463 Lentz Rd Statesville NC 28625

SITE ADDRESS: 141 Beulah Rd Statesville NC 28677 | PHONE: 980 829 3278 | ALT. PHONE 706 244 5966

SITE DIRECTIONS: 140 W → Old Mountain Rd → (R) Beulah Rd → on (L) | SAP CONTROLLED: ☐ YES ☒ NO

SUBDIVISION: — | SECTION: — | LOT # — | LOT AREA: 2.2 | DESIGN FLOW: 360 | L.T.A.R.(Initial): — | L.T.A.R (Repair): 0.3

Septic Tank	1000 (gal)	STB	Date	☐ New System	☒ Repair	☐ Expansion	System Type: I II (III) IV V VI	☒ Residence	No. Bedrooms 3
Pump Tank	(gal)	PT	Date	System Description:	EXISTING			☐ Business	No. Persons 6
Pump Make	Model		Serial #	Repair System Description:	GRAVITY 25% REDUCTION			☐ Other	No. Employees —
# Nitrification Fields	1 # Lines 7		Linear Ft 300'	Maintenance Agreement Required:	☐ YES	☒ NO		☐ Slab	☒ Crawl Space
Trench Width	36" *Max. Trench Depth(Initial) —		*Max. Trench Depth(Repair) 33" Gravel Depth —		☒ GRAVITY	☐ PRESSURE		☐ Basement w/plumbing	☐ Basement w/o plumbing


* Measured on the downhill side of the trench | Effluent Standard: ☒ DSE ☐ HSE ☐ TS-I ☐ TS-II ☐ RCW ☐ NSF/ANSI 40 | Usable Depth to LC (Initial): — | Usable Depth to LC (Repair): 49 *Limiting Condition*

Water Supply: ☒ Private ☒ Public ☐ Community

Comments / Conditions: Pump, crush, fill existing tank. Keep 2' separation from existing bed. Keep 50' from well. Install on contour 9' on center utilizing serial distribution.

* 50' radius may need to be survey marked to designate well setbacks. *

INITIAL SITE SKETCH

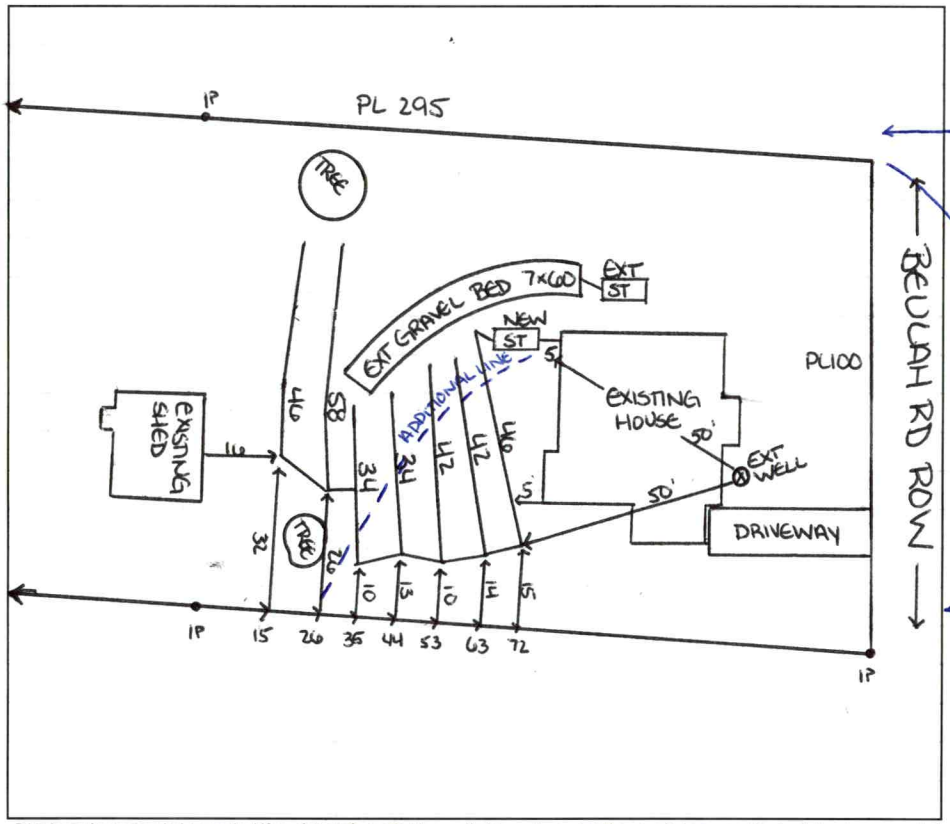


AS BUILT SKETCH

FOR SEPTIC FINAL INSPECTION CALL: 704-664-3703 between 8am-9am

the day the inspection is needed. Be sure to speak with an inspector to confirm your time.

See additional line found at install. See pit 3 notes at install on notes.

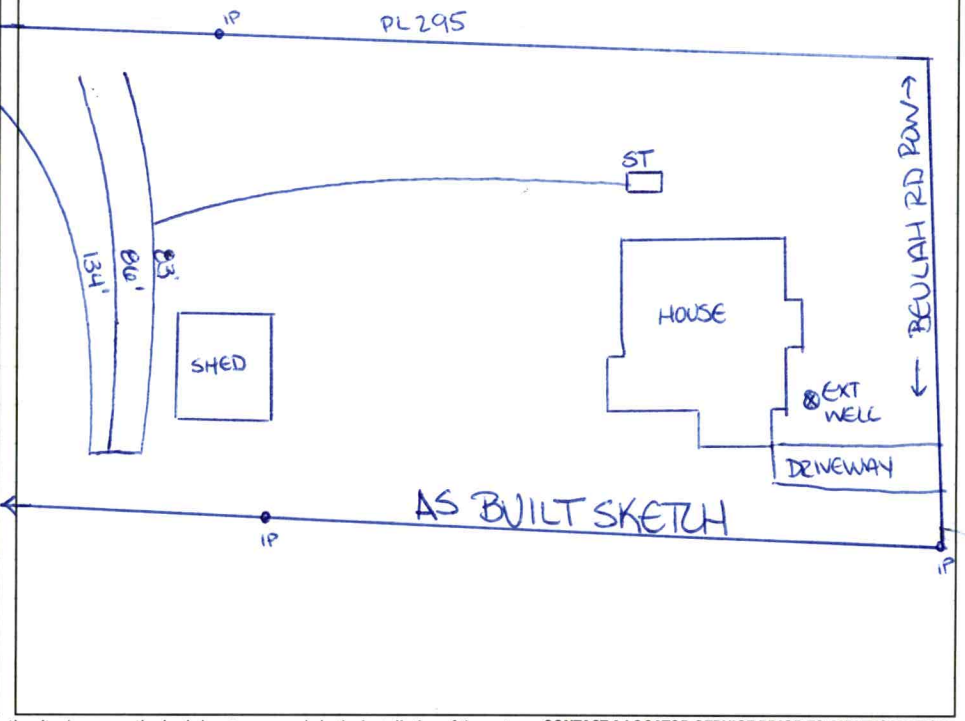

Permit can be suspended or revoked if any false information is supplied toward securing the permit / any unauthorized changes are made to the site / any unauthorized changes are made in the installation of the system. **CONTACT A LOCATOR SERVICE PRIOR TO ANY EXCAVATION**

☐ **IMPROVEMENT PERMIT** ***with plat*** *valid without expiration.* ☒ **IMPROVEMENT PERMIT** ***with site plan*** *valid for 60 mos.* ☒ **AUTHORIZATION TO CONSTRUCT** *valid for period equal to IMPROVEMENT PERMIT--not to exceed 60 mo.*

Owner / Applicant Signature: ONLINE | Date: — | Installed by: Lentz Wastewater

IMPROVEMENT PERMIT by: Sarah Williams | Date: 10/30/2024 | OPERATION PERMIT by: Sarah Williams | Date: 11/22/2024

AUTHORIZATION TO CONSTRUCT by: Sarah Williams | Date: 10/30/2024 | Existing System Inspected by: | Date:

Item	Date	Initials
Drain Lines Checked		
Tanks Checked		
Pressure Manifold or Valve Box Checked		
Pressure Head Set		
Electrical Checked		
Floats Set		
Alarm Checked		
Maintenance Contract Needed? Y / N		
Comments:		

Repairs Only	
	State Code
Failing System Code	
Type of Distribution	G or P
Type of Failure/Malfunction	
Primary Cause of Failure/Malfunction	
Age of System? _____	
Initial or Repair? _____	

PERMIT SNAPSHOT REPORT OSWP-2024-64048 FOR IREDELL COUNTY

Permit Type	Environmental Health OSWP	**Project:**		**App Date:**	10/23/2024
Work Class:	EH Septic Permit	**District:**	Iredell County	**Exp Date:**	NOT AVAILABLE
Status:	PRIORITY PERMIT	**Square Feet:**	0.00	**Completed:**	NOT COMPLETED
Valuation:	$0.00	**Assigned To:**	Williams, Sarah	**Approval Expire Date:**	
Description:	Homemade septic tank. Drain lines are failing—oversaturated and frequent pumping.				

Parcel: 4704709463.000 Main	**Address:** 141 Beulah Rd Statesville, NC 28677 Main	**Zone:** RA(Residential Agricultural District)

Applicant/Authorized Agent Jeanie Lentz Home: (980) 829-3278	Property Owner Sybil Tyson Home: (706) 244-5966	Applicant/Authorized Agent Jeanie Lentz 463 Lentz Road Statesville, NC 28625

Permit Custom Fields

How is your site plan being submitted	Custom Site Plan	Septic Application/Permit Type	Repair	Does the site contain any jurisdictional wetlands	No
Non-domestic Sewage Generated	No	Other Public Agency	No	All proposed structure dimensions	N/A
What are the proposed structures	Other Addition/Structure	Maximum Number of Bedrooms	3	If other Addition/Structure, please explain	
Number of Occupants	1	Foundation Type	Crawl Space Foundation	Water Supply	Other Public Water
Desired Septic System Type	No Preference	If other septic system type, please explain		Pump Make	
# of Nitrification Fields		Model		Serial #	
System Description		Repair System Description		Comments/Conditions	
Permit type(s)	Authorization to Construct	Additional Unique Setbacks Apply	No		

Attachment File Name	Added On	Added By	Attachment Group	Notes
Signature_Jeanie_Lentz_10/23/2024.jpg	10/23/2024 13:56	Lentz, Jeanie		Uploaded via CSS
141 Beulah Rd Site Plan_v1.pdf	10/23/2024 14:37	Lentz, Jeanie	Available Online	
141_Beulah_Rd-Authorize_Legal_Representative-mayeve1_live.com_v1.pdf	10/23/2024 14:37	Lentz, Jeanie	Available Online	


Workflow Step / Action Name	Action Type	Start Date	End Date
Application Completeness Check v.1		10/23/2024 14:37	10/23/2024 14:37
Confirm application complete v.1	Generic Action		10/23/2024 14:37
Lot Readiness Verification v.1			
~~OSWP Septic Preliminary Site Visit v.1~~	Inspection		10/23/2024 14:37
OSWP Site Evaluation v.1	Inspection		
~~**Zoning Review v.1**~~			10/23/2024 14:37
~~Floodplain Admin Overview v.1~~	Task		10/23/2024 14:37
~~Iredell County Zoning Approval v.1~~	Task		10/23/2024 14:37
~~Issue Invoice v.1~~	Generic Action		10/23/2024 14:37
~~Fees Paid v.1~~	Generic Action		10/23/2024 14:37
Fees v.1			
Issue Invoice v.1	Generic Action		
Fees Paid v.1	Generic Action		

PERMIT SNAPSHOT REPORT (OSWP-2024-64048)


Issue Improvement Permit v.1	
Issue Invoice v.1	Generic Action
Fees Paid v.1	Generic Action
Issue Permit v.1	Generic Action
Permit Completion Process v.1	
Authorization to Construct Permit v.1	Create Sub Permit
Issue Authorization to Construct v.1	Generic Action

AB 1) 0-21 C BK — SSSP SEFK — (49) — — — S
21-49 CL BK — ⊥ — few mica in C — 0.3
few SAP in CL

AB 2) 0-10 DIST FILL — — — — — — S
10-34 C BK — SSSP SEFR — (48) — few mica in C — 0.3
34-49 CL BK — ⊥ — few SAP incl in CL

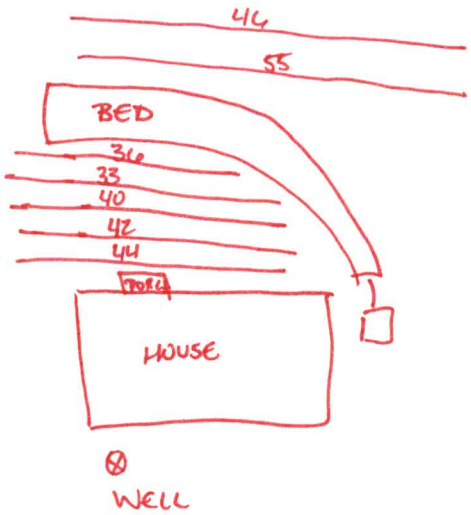

PIT 3) 0-7 SCL SBK — SS SP SEFK — (51) — — — S
7-36 C ABK — ⊥ — few lithar SAP incl in CL — 0.3
36-51 CL WABK

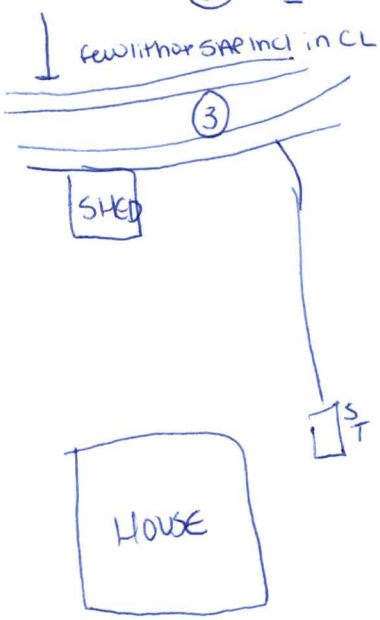

IREDELL COUNTY HEALTH DEPARTMENT

Statesville Phone TR 3-7271 Mooresville Phone No. 664-5281

PERMIT TO INSTALL SEPTIC TANK

Permit No. 3 Permit Date 4-16 19 73

Owner Allen Bustle Address Statesville NC

Installed By Alexander Septic Tank Co. Address Stony Point NC


Location of Property Hickory Hwy to old Mountain Rd T.R. then T.L. at Beaulah Baptist Church 3rd house on L.

Tank		Capacity		Length of Lines		Fixtures	
Block	( )	1000	( )	225'	(✓)	No. of Baths	( )
Precast	( )	1250	( )	250'	( )	Dishwasher	( )
		1500	( )	Other		Garbage Grdr.	( )
		Other				Other	

NOTIFY HEALTH DEPARTMENT AT LEAST EIGHT HOURS BEFORE TANK IS TO BE INSPECTED.

Final Inspection 4-16 1973 Approved (✓) Disapproved ( )

Remarks

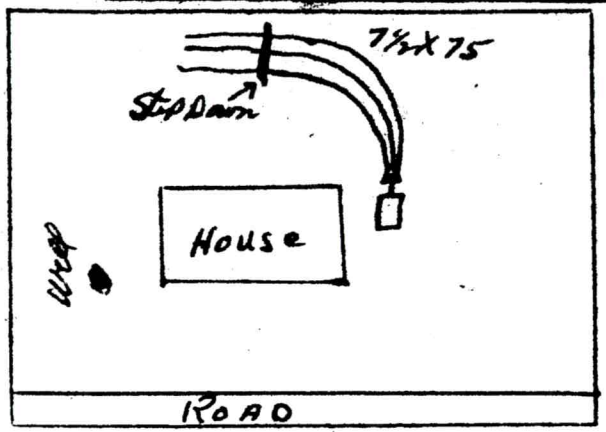


Sketch of Installation

used existing tank but all new lines

Repair

E. G. Stevenson

Sanitarian

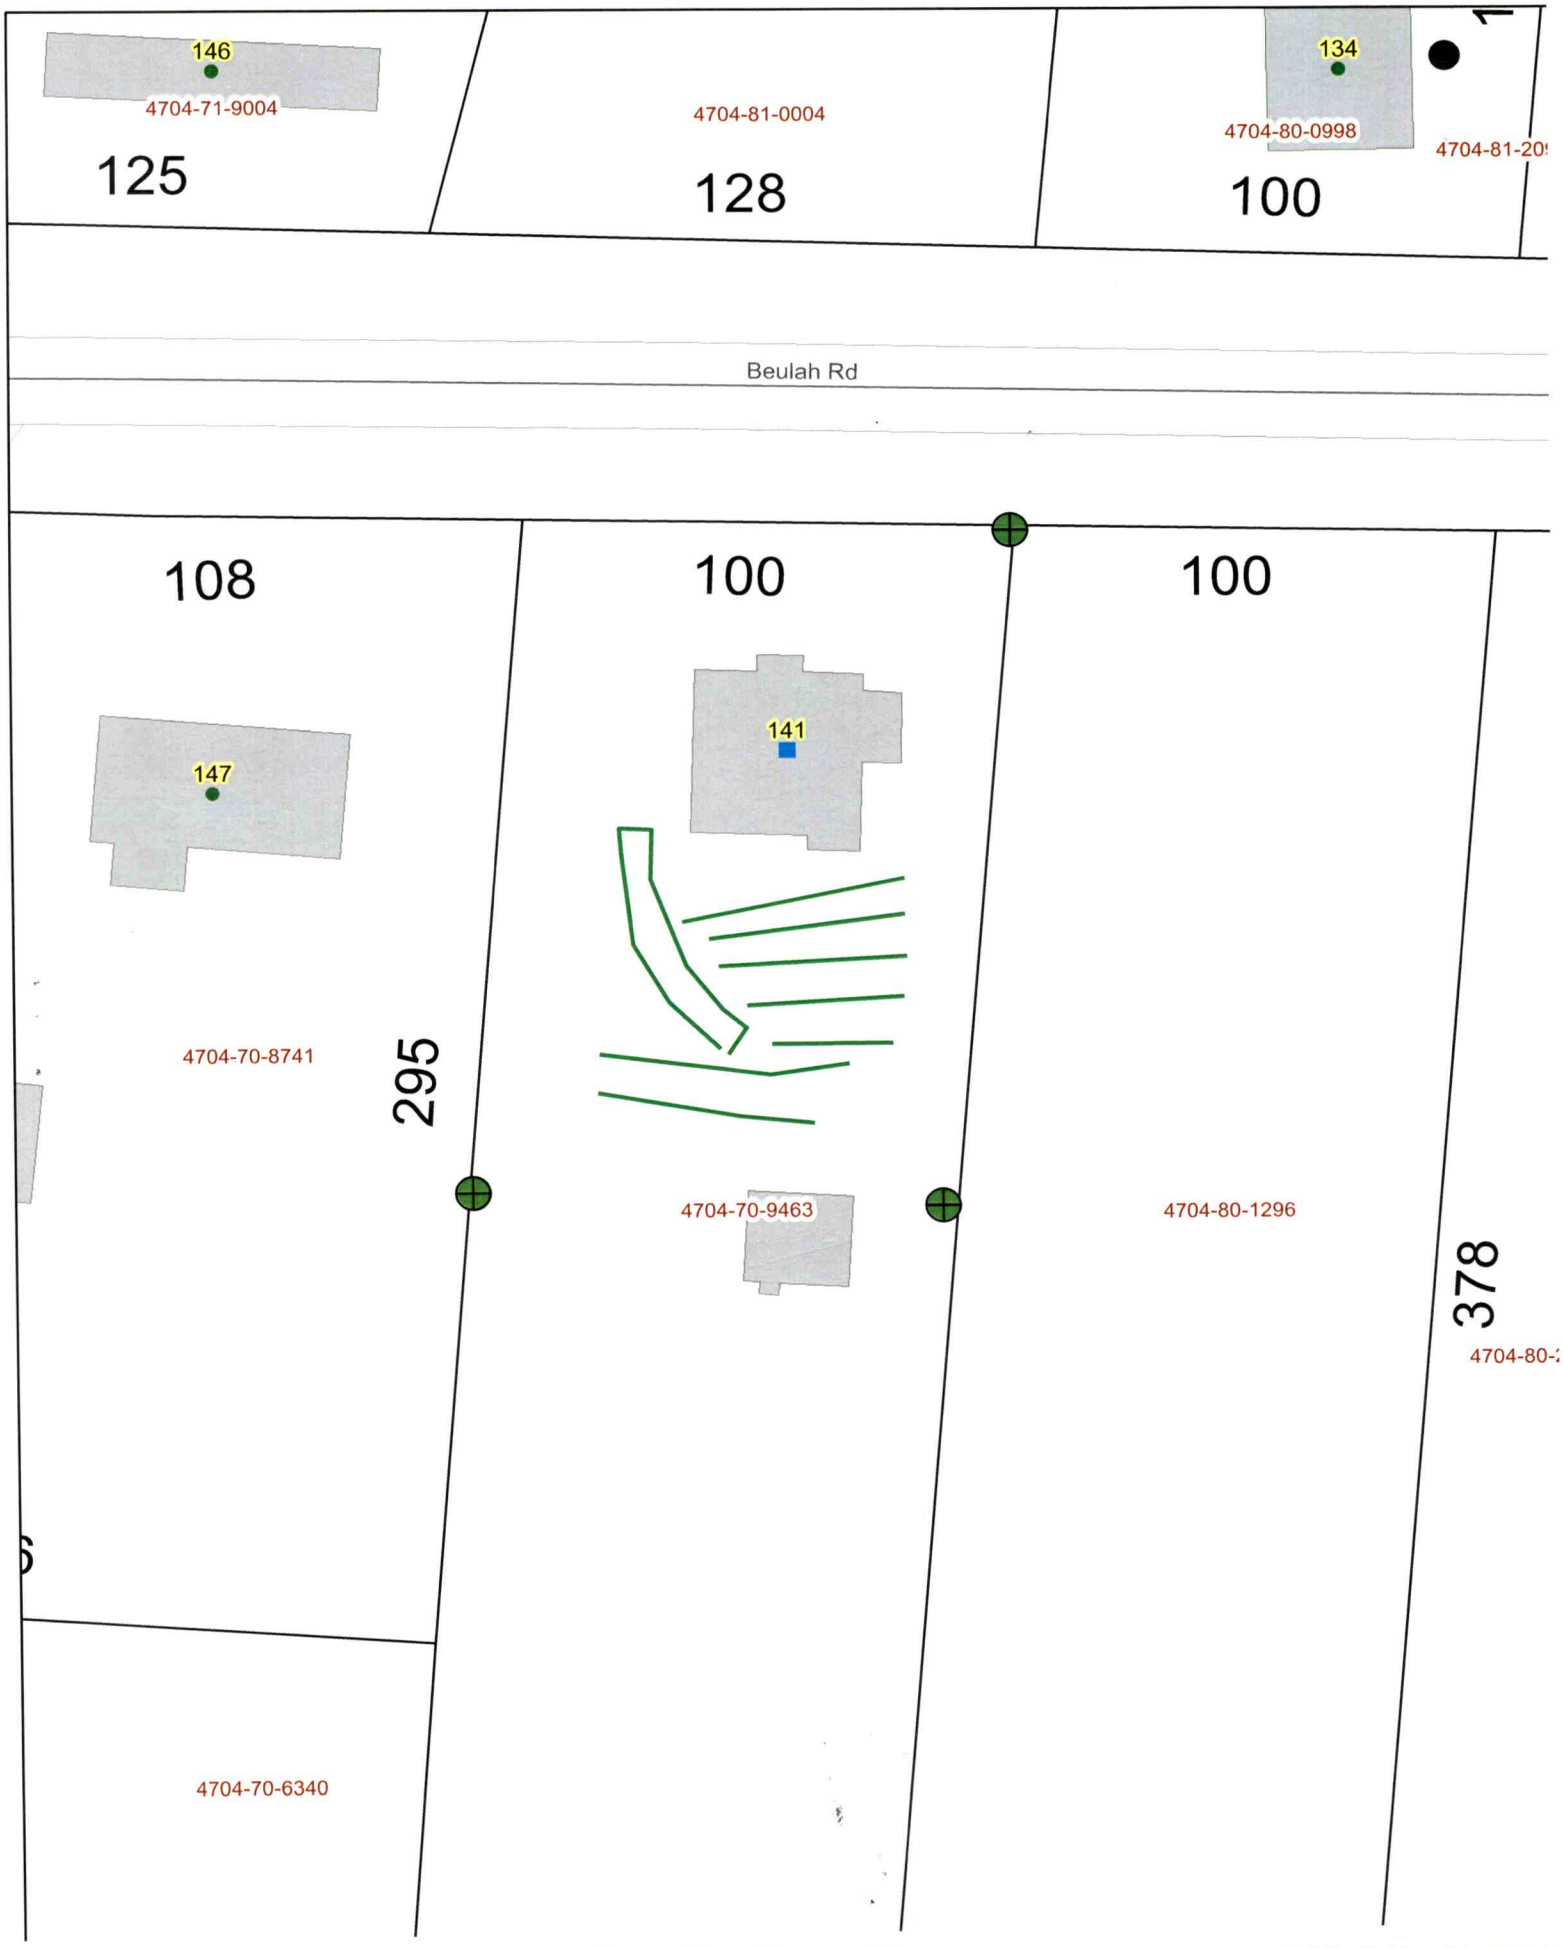
146
4704-71-9004
125
4704-81-0004
128
134
4704-80-0998
100
Beulah Rd
108
100
100
147
141
4704-70-8741
295
4704-70-9463
4704-80-1296
378
4704-70-6340