IREDELL COUNTY HEALTH DEPARTMENT

Statesville Phone TR 3-7271 Mooresville Phone No. 664-5281

PERMIT TO INSTALL SEPTIC TANK

Permit No. _____ Permit Date 4-16 1973

Owner Allen Bustle Address Statesville NC

Installed By Alexander Septic Tank Co Address Stony Point NC


Location of Property Hickory Hwy to old Mountain Rd T.R. then T.L. at Beaulah Baptist Church 3rd house on L.

Tank		Capacity		Length of Lines		Fixtures	
Block	( )	1000	( )	225'	(✓)	No. of Baths	( )
Precast	( )	1250	( )	250'	( )	Dishwasher	( )
		1500	( )	Other _____		Garbage Grdr.	( )
		Other _____				Other _____	

NOTIFY HEALTH DEPARTMENT AT LEAST EIGHT HOURS BEFORE TANK IS TO BE INSPECTED.

Final Inspection 4-16 1973 Approved (✓) Disapproved ( )

Remarks _____

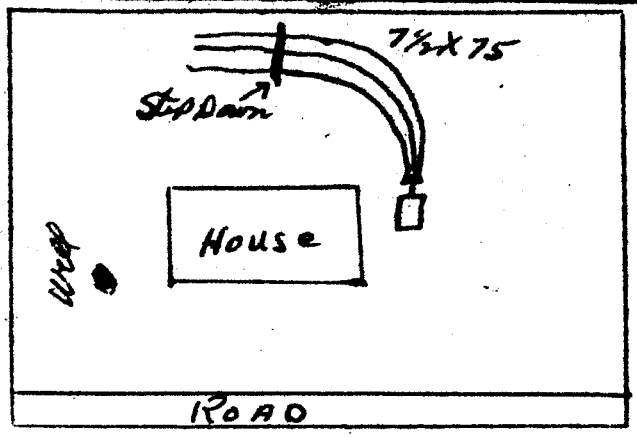

Sketch of Installation

used existing tank but all new lines

Repair

E. G. Stevenson

Sanitarian