IREDELL COUNTY HEALTH DEPARTMENT

Statesville Phone TR 3-7271 Mooresville Phone NO 3-1271

PERMIT TO INSTALL SEPTIC TANK

Permit No. [illegible] Permit Date 7-5 1973

Owner Jonathan Byers Address Statesville N.C.

Installed By Raymond Adams Address Hiddenite N.C.


Location of Property Hwy 64 W. Past White Oak T.L. into Shiloh Acres. T.R. 1st Street. White house on R. at end of street

Tank		Capacity		Length of Lines		Fixtures	
Block	( )	1000	(✓)	225'	(✓)	No. of Baths	(1)
Precast	(✓)	1250	( )	250'	( )	Dishwasher	( )
		1500	( )	Other		Garbage Grdr.	( )
		Other				Other	

NOTIFY HEALTH DEPARTMENT AT LEAST EIGHT HOURS BEFORE TANK IS TO BE INSPECTED.

Final Inspection 7-5 1973 Approved (✓) Disapproved ( )

Remarks W. Iredell water Corp.

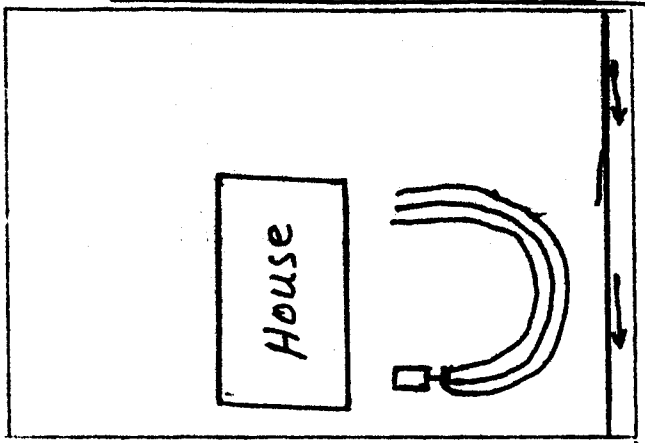

Sketch of Installation

E. A. Stevenson

Sanitarian