IREDELL COUNTY HEALTH DEPARTMENT - *ENVIRONMENTAL HEALTH* ☐ STATESVILLE OFFICE 704-878-5305 ☐ MOORESVILLE OFFICE 704-664-5281

IMPROVEMENT PERMIT / AUTHORIZATION TO CONSTRUCT / OPERATION PERMIT / EXISTING SYSTEM INSPECTION

PERMIT # Repair PIN # 4764-71-6636 DATE 7 October 10

OWNER Bo B Quick Stop / APPLICANT: Chad Byers PHONE: Home/Cell # Business # (704) 902-4441

SITE ADDRESS 114 Water Tank Rd. Statesville OWNER / APPLICANT ADDRESS

SITE DIRECTIONS I40 W Turn Left on old mtn. Rd. - Cross I-40 - on Rt.


SUBDIVISION BLOCK / SECTION LOT # LOT AREA 10.64 ac. DESIGN FLOW *240 gpd L.T.A.R. 0.3

Septic Tank Exist.	Gallons: STB	Date	☐ New System	☑ Repair	☐ Expansion System	Type I II (III) IV V VI	☐ Residence	No. Bedrooms	Water Supply
Pump Tank	Gallons: P T	Date	System Description:				☑ Business *	No. Persons	☐ Private
Pump Make	Model	Serial #	Repair System Description:	25% Reduction			☐ Other	No. Employees 2	☑ Public
No. Nitrification Fields: 1	No. Lines 3	Linear Feet 200	Maintenance Agreement Required	☐ YES	☑ NO		☑ Slab	☐ Crawl Space	☐ Community
Trench Width 36"	Max. Trench Bottom Depth 36"		Gravel Depth N/A	☑ GRAVITY	☐ PRESSURE		☐ Basement w/plumbing	☐ Basement w/o plumbing	

Comments / Conditions * Design Flow from water usage records.
1 X 100' 2 X 50'

* Convenience Store
* Easement from Duke Power Attached.

INITIAL SITE SKETCH

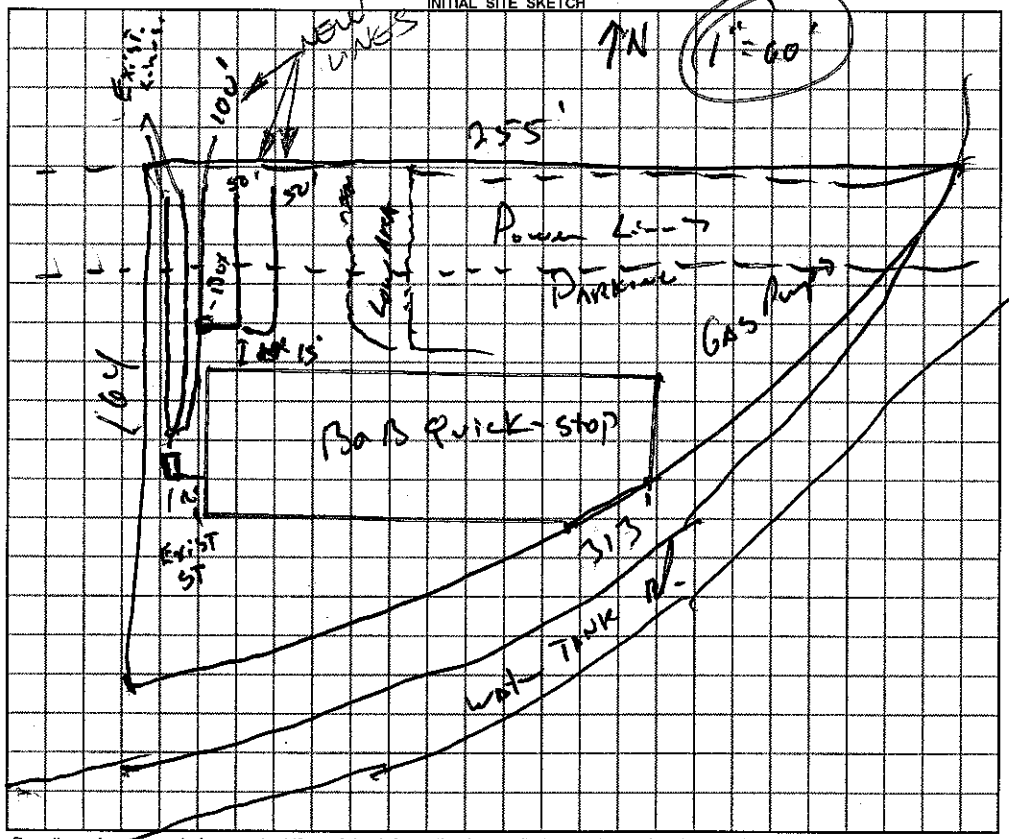

AS BUILT SKETCH

Permit can be suspended or revoked if any false information is supplied toward securing the permit / any unauthorized changes are made to the site / any unauthorized changes are made in the installation of the system.

☐ ***IMPROVEMENT PERMIT*** *with plat valid without expiration.* ☐ ***IMPROVEMENT PERMIT*** *with plat valid without expiration.* ☑ ***AUTHORIZATION TO CONSTRUCT*** valid for period equal to IMPROVEMENT PERMIT--not to exceed 60 mo.

Owner / Applicant Signature: Date Installed by: Craig Thompson Tommy Fiore

IMPROVEMENT PERMIT by: REHS Date OPERATION PERMIT by: REHS Date 10/15/10

AUTHORIZATION TO CONSTRUCT by: REHS Date 7 Oct. 10 Existing System Inspected by: REHS Date

YOU SHOULD CONTACT A LOCATOR SERVICE PRIOR TO ANY EXCAVATION

White Copy – Environmental Health YELLOW COPY (Final) Owner / Applicant PINK COPY (Initial) Owner / Applicant