IREDELL COUNTY HEALTH DEPARTMENT

Statesville Phone TR 3-7271 Mooresville Phone No. 664-5281

PERMIT TO INSTALL SEPTIC TANK

Permit No. 1161 Permit Date 6-8 1973

Owner Shiloh Grille (Troy Cash) Address Statesville N.C.

Installed By Robert Hoke (R.E. Foy) Address Statesville NC.


Location of Property Out I-40 W to old Mountain Rd - Grill on Right at Exit.

Tank		Capacity		Length of Lines		Fixtures	
Block	( )	1000	(✓)	225'	( )	No. of Baths	( )
Precast	(✓)	1250	( )	250'	( )	Dishwasher	( )
		1500	(✓)	Other 880'		Garbage Grdr.	( )
		Other				Other	

NOTIFY HEALTH DEPARTMENT AT LEAST EIGHT HOURS BEFORE TANK IS TO BE INSPECTED.

Final Inspection 6-8 1973 Approved (✓) Disapproved ( )

Remarks West Iredell Water Corp.

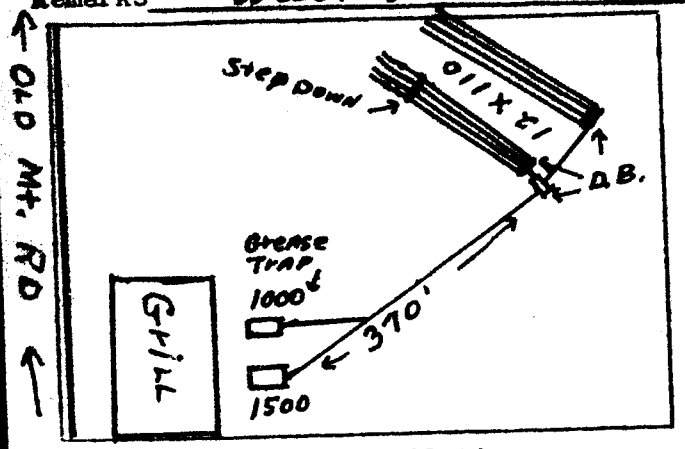

Sketch of Installation

Clean out every 80' in solid line

E. A. Stevenson

Sanitarian