Voids Previous Permits

IREDELL COUNTY HEALTH DEPARTMENT

STATESVILLE 704-878-5305 MOORESVILLE 704-664-5281

IMPROVEMENT PERMIT / AUTHORIZATION TO CONSTRUCT / OPERATION PERMIT / EXISTING SYSTEM INSPECTION

PERMIT# 8664 PIN# 4704639703 DATE Feb 23 2000

OWNER OR CONTRACTOR QUALITY CAR CAR / Dean Goodwin PHONE: Business 871 2535 Home

ADDRESS 2879-B Amity Hill Rd Statesville 28677

LOCATION I40 W (R) Old NT Rd (R) Conifer 700ft on Right before 14M Motor Sports

SUBDIVISION BLOCK / SECTION LOT LOT AREA 43520 Sq FT SITE CLASS. PS DESIGN FLOW 100 L.T.A.R. .3

Septic Tank: 1000 Gallons; STB 1012 Date 3-5-00

Pump Tank: Gallons; PT Date

Pump Make: Model Serial No.

Nitrification Field: No Fields 1 Square Feet 336 Linear Feet 112

No Lines 2 Trench Width 36" Max Trench Bottom Depth 36" Gravel Depth 12"

[X] New System [ ] Repair System Type: I [II] III IV V VI

System Description: Conv. GRAVITY

Repair System Description: SAME

Maintenance Agreement Required: [ ] Yes [X] No

[ ] House/Mod. Home No. Bedrooms

[ ] Mobile Home No. Bathrooms 2

[X] Business No. Employees 4

[ ] Other

[X] Slab [ ] Crawl Space [ ] Basement w/plumbing [ ] Basement wo/plumbing


Water Supply: [ ] Individual [X] Public [ ] Community

Comments/Conditions: This system is for domestic sewage only. No floor drains in building or outside that will be run into septic tank. See Building Code on Size & Type of Collection sewer & for Cleanouts


Comments/Conditions: LOCATE TANK TO INSURE GRAVITY from building and fall to Septic Lines

INITIAL SITE SKETCH

Not To Scale

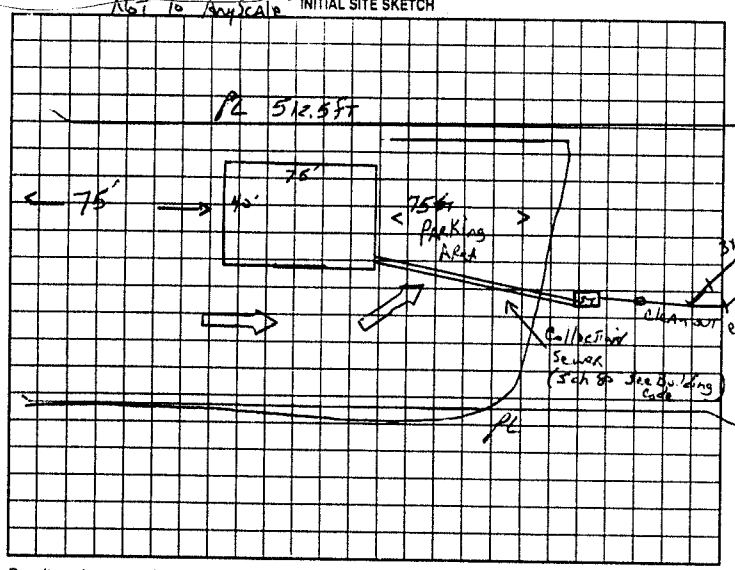

AS BUILT SKETCH

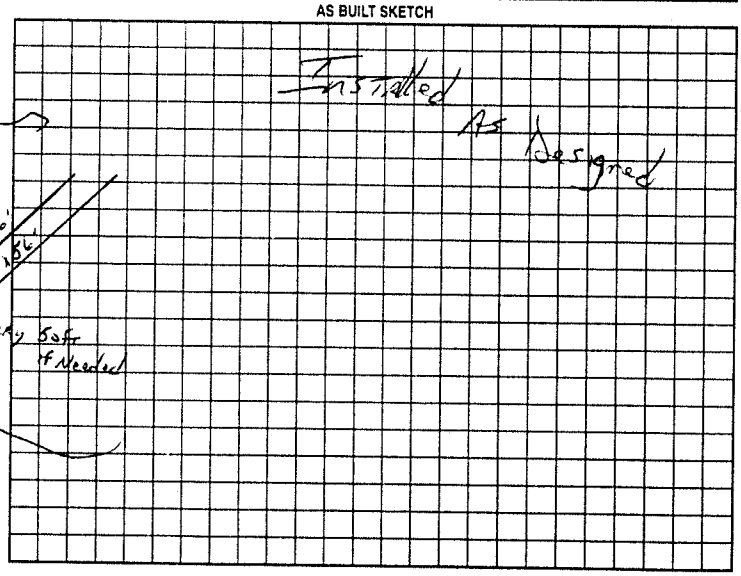

Permit can be suspended or revoked if any false information is supplied toward securing the permit/any unauthorized changes are made to the site/any unauthorized changes are made in the installation of the system. Improvement Permit with plat valid without expiration. Improvement Permit with site plan valid for sixty months. Authorization to Construct is valid for a period equal to that of Improvement Permit – not to exceed sixty months.

Signed: date Feb 23-2000 Installed by: R. Rackley

Improvement Permit by: C. Potter date Feb 23 2000 Operation Permit by: C. Potter date May 11-2000

Authorization to Construct by: C. Potter date Feb 23 2000 Existing System Inspection by: date

HEALTH DEPT. COPY: WHITE OWNER COPY (FINAL): YELLOW OWNER COPY (INITIAL): PINK