IREDELL COUNTY HEALTH DEPARTMENT

STATESVILLE 704-878-5305 MOORESVILLE 704-664-5281

IMPROVEMENT PERMIT / AUTHORIZATION TO CONSTRUCT / OPERATION PERMIT / EXISTING SYSTEM INSPECTION

PERMIT# 071119 PIN# 4704 73 2774 DATE 1-6-98

OWNER OR CONTRACTOR JOHN W. MICHALOWSKI PHONE: Business 876-2248 Home 873-8958

ADDRESS 153 MOCKINGBIRD DRIVE, STATESVILLE, NC 28677

LOCATION I-40 W, TR OLD MOUNTAIN ROAD, TR CONIFER DRIVE, 800 FEET ON RIGHT

SUBDIVISION _____ BLOCK / SECTION _____ LOT _____ LOT AREA 3.1544 ACRES SITE CLASS. PS DESIGN FLOW 200 L.T.A.R. 0.30 GPD/FT²

Septic Tank: 1000 Gallons; STB 825 Date 11-11-98
Pump Tank: _____ Gallons; PT _____ Date _____
Pump Make: _____ Model _____ Serial No. _____
Nitrification Field: No Fields 1 Square Feet 675 Linear Feet 225
No Lines THREE Trench Width 36" Max Trench Bottom Depth 36" Gravel Depth 12"

[X] New System [ ] Repair System Type: I II III IV V VI
System Description: CONVENTIONAL, GRAVITY
Repair System Description: CONV. GRAVITY
Maintenance Agreement Required: [ ] Yes [X] No
[X] Slab [ ] Crawl Space [ ] Basement w/plumbing [ ] Basement wo/plumbing


[ ] House/Mod. Home No. Bedrooms ____
[ ] Mobile Home No. Bathrooms ____
[X] Business No. Employees 8
[ ] Other RACE SHOP

Water Supply: [ ] Individual [X] Public [ ] Community


Comments:/Conditions: ① INSTALL SUBSURFACE DRAINAGE DITCH TO INTERCEPT LATERAL WATER MOVEMENT BEGINNING 48" DEEP CONTINUING OUT TO DAYLIGHT ② INSTALL LINES ON CONTOUR AS FLAGGED ③ NO CUTTING OR FILLING OVER DRAINFIELD.

Comments:/Conditions:

INITIAL SITE SKETCH SCALE: 1" = 80'

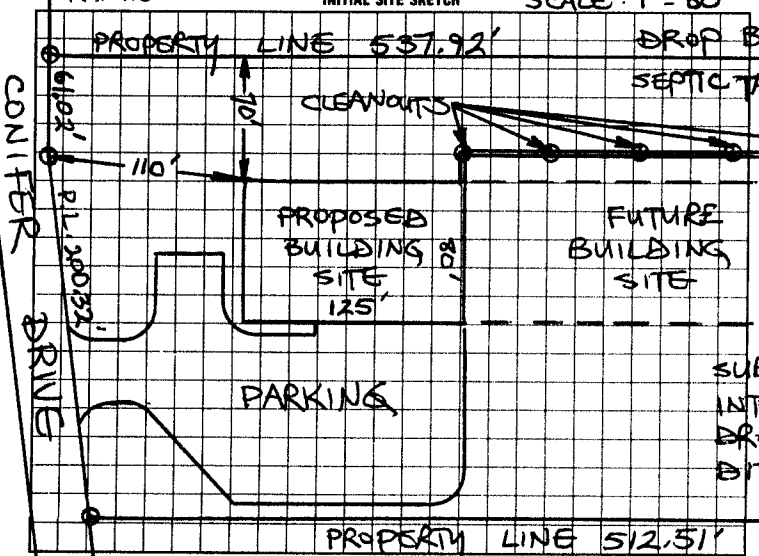

AS BUILT SKETCH

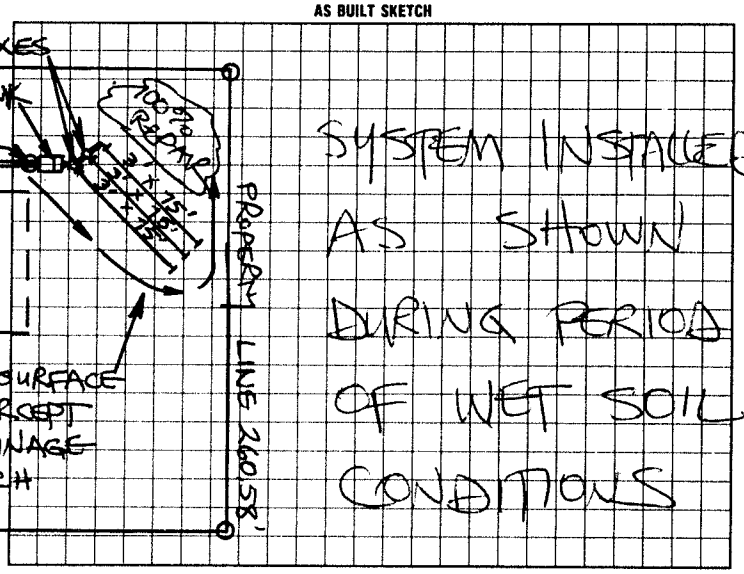

I understand that this permit can be suspended or revoked if any false information is supplied toward securing the permit/any unauthorized changes are made to the site/any unauthorized changes are made in the installation of the system. Improvement Permit with plat valid without expiration. Improvement Permit with site plan valid for sixty months. Authorization to Construct is valid for a period equal to that of Improvement Permit – not to exceed sixty months.

Signed: _____ date 1-6-98 Installed by: C & W GRADING

Improvement Permit by: STEVE HEDRICK date 1-6-98 Operation Permit by: STEVE HEDRICK date 1-19-99

Authorization to Construct by: STEVE HEDRICK date 1-6-98 Existing System Inspection by: _____ date _____

HEALTH DEPT. COPY: WHITE INSPECTION COPY (FINAL): GREEN OWNER COPY (FINAL) YELLOW INSPECTION COPY (INITIAL) PINK OWNER COPY (INITIAL): GOLD