Paid $50 10/9/96

THIS PERMIT VOIDS PREVIOUS ISSUED 8-7-96 63359

IREDELL COUNTY HEALTH DEPARTMENT

STATESVILLE 704-878-5305 MOORESVILLE 704-664-5281

IMPROVEMENT PERMIT / CERTIFICATE OF COMPLETION / OPERATION PERMIT / EXISTING SYSTEM INSPECTION

PROPERTY DESCRIPTION NO. 22921 DATE 10-8-96 TAX MAP NO. 8M-A-70 (PART OF) Watershed: ☐ Yes ☑ No

OWNER OR CONTRACTOR PAO LEE PHONE: Business Home (910) 439-5581

ADDRESS RT-2, BOX 126, MT. GILEAD, NC 27306

LOCATION I-40 W, TR OLD MTN ROAD, TR CONIFER DRIVE, 1ST DRIVE ON RIGHT, 2ND LOT ON LEFT

SUBDIVISION BLOCK / SECTION LOT LOT AREA 2 ACRES SITE CLASS. PS DESIGN FLOW 360 L.T.A.R. .030 GPD/FT²

Septic Tank: 1000 Gallons; STB 825 Date 9-16-96

Pump Tank: Gallons; PT Date

Pump Make: Model Serial No.

Nitrification Field: No Fields 1 Square Feet 1200 Linear Feet 400

No Lines FOUR Trench Width 36" Max Trench Bottom Depth 30" Gravel Depth 12"

☑ New System ☐ Repair System Type: I, II, III, IV, V, VI

System Description: CONVENTIONAL GRAVITY

Repair System Description: CONV. GRAVITY

Maintenance Agreement Required: ☐ Yes ☑ No

☐ House/Mod. Home No. Bedrooms 3

☑ Mobile Home No. Bathrooms 2

☐ Business No. Employees

☐ Other


☐ Slab ☑ Crawl Space ☐ Basement w/plumbing ☐ Basement wo/plumbing

Water Supply: ☐ Individual ☐ Community ☑ Public

Comments: INSTALL ON CONTOUR AS FLAGGED

Comments:

INITIAL SITE SKETCH

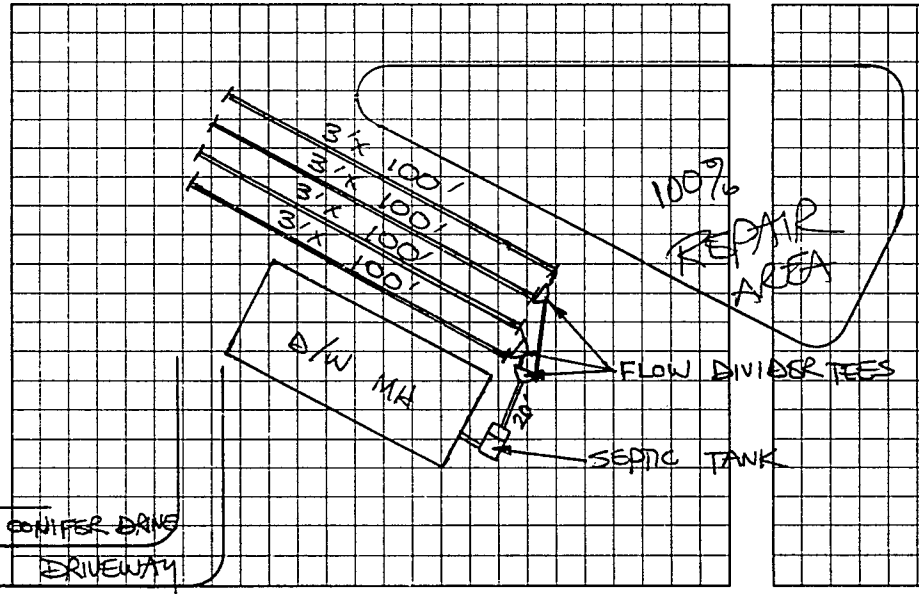

AS BUILT SKETCH

Installed as shown

I understand that this permit can be suspended or revoked if any false information is supplied toward securing the permit/any unauthorized changes are made to the site/any unauthorized changes are made in the installation of the system.

AUTH. TO CONST. IS VALID FOR A PERIOD EQUAL TO THE VALIDITY OF THE I.P. NOT TO EXCEED FIVE YEARS. I.P. W/SITE PLAN IS VALID FIVE YEARS.

Signed: Pao Lee Installed by: Rowan Septic

Improvement Permit by: ~~Steve Hedrick~~ date 10-8-96

AUTHORIZATION TO CONSTRUCT ~~Existing System Inspection by~~ Steve Hedrick date 10-8-96

~~Certificate of Completion by~~ date

Operation Permit by Mark C Osborne RS date 10-29-96

HEALTH DEPT. COPY: WHITE INSPECTION COPY (FINAL): GREEN OWNER COPY (FINAL): YELLOW INSPECTION COPY (INITIAL): PINK OWNER COPY (INITIAL): GOLD

26100