IREDELL COUNTY HEALTH DEPARTMENT

STATESVILLE 704-878-5305 MOORESVILLE 704-664-5281

IMPROVEMENT PERMIT / AUTHORIZATION TO CONSTRUCT / OPERATION PERMIT / EXISTING SYSTEM INSPECTION

PERMIT# 141465 PIN# 4704 73 7521 DATE 4-20-07

OWNER OR APPLICANT TRIA YANG PHONE: Business Home 704-872-9846

ADDRESS 236 UPPARD FARM RD, STATESVILLE, NC 28625

LOCATION I-40 WEST, TR OLD MTN. ROAD TR LARUE CIRCLE, TL CHENG DRIVE, 1ST ON LEFT AT CURVE,

SUBDIVISION CHENG YANG BLOCK / SECTION LOT 4 & 2 LOT AREA 2.537 ACRES SITE CLASS. PS DESIGN FLOW 480 L.T.A.R. 0.25 GAD/FT

Septic Tank: 1000 Gallons; STB GST 1600 Date 9-25-07

Pump Tank: Gallons; PT Date

Pump Make: Model Serial No.

Nitrification Field: No Fields 1 Square Feet 1920 Linear Feet 480

No Lines SIX Trench Width 36" Max Trench Bottom Depth 30

☑ New System ☐ Repair ☐ Expansion System Type: I II III IV V VI

System Description: 25% REDUCTION, GRAVITY

Repair System Description: 50% REDUCTION, GRAVITY

Maintenance Agreement Required: ☐ Yes ☑ No

Gravel Depth N/A ☑ Gravity ☐ Pressure

☑ House/Mod. Home ☐ Mobile Home ☐ Business ☐ Other

No. Bedrooms 4 No. Persons No. Employees


Water Supply: ☑ Individual ☐ Public ☐ Community WELL

☐ Slab ☑ Crawl Space ☐ Basement w/plumbing ☐ Basement wo/plumbing


Comments:/Conditions: INSTALL 25% REDUCTION SYSTEM ON CONTOUR AS FLAGGED, NO DEEPER THAN 30 INCHES, USE ONE FLOW DIVIDER TEE TO ACHIEVE EQUAL DISTRIBUTION INTO TWO SETS of

Comments:/Conditions: R: Septic tank has marker / Filter installed.

INITIAL SITE SKETCH

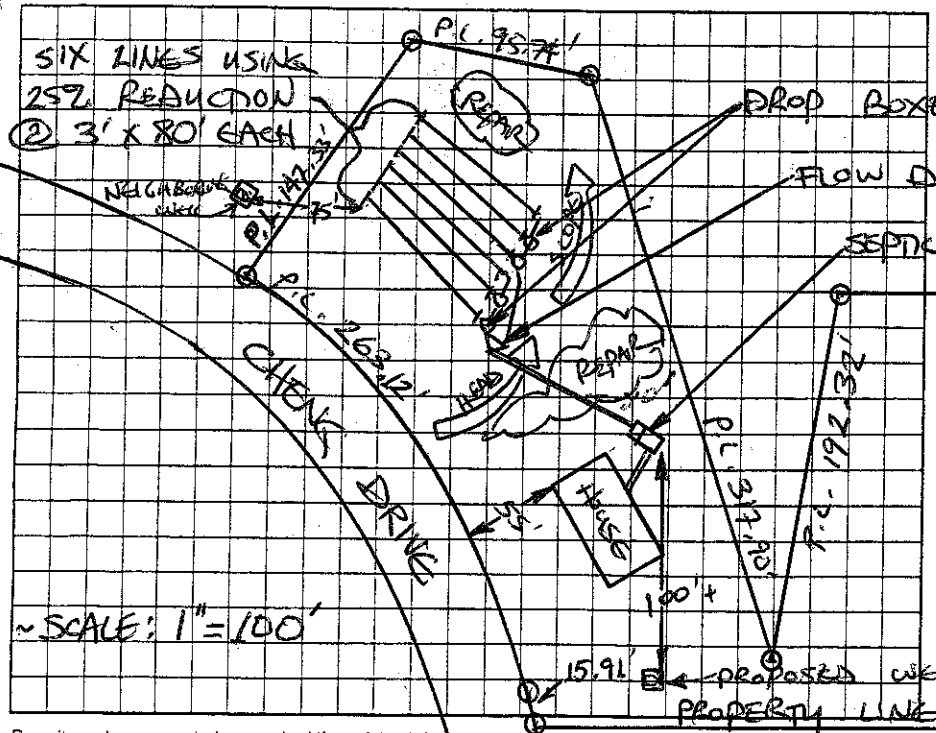

AS BUILT SKETCH

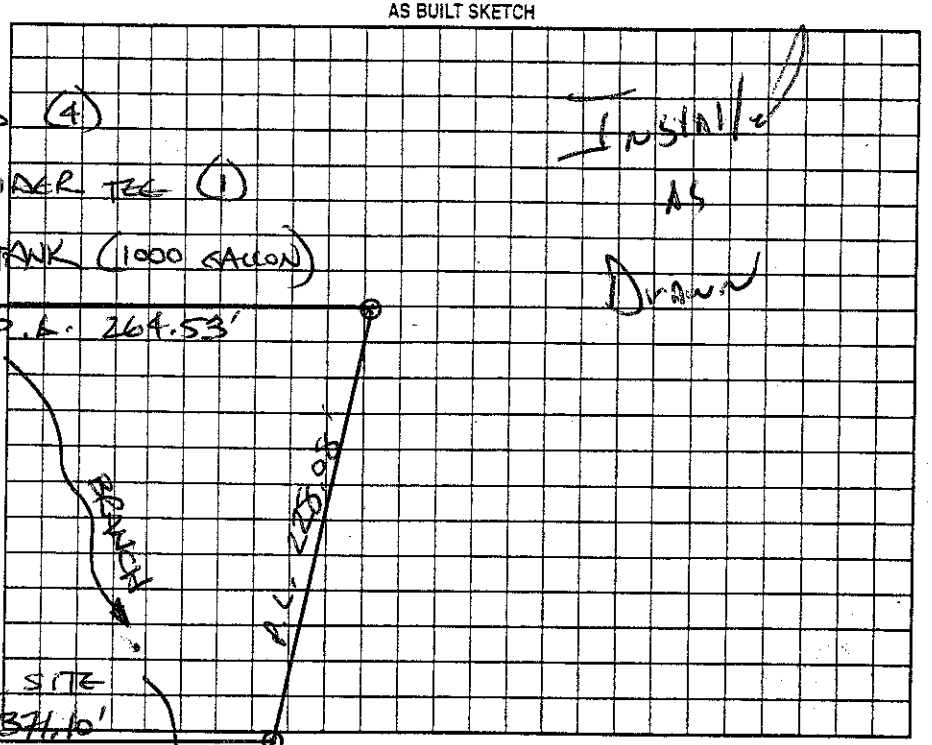

Permit can be suspended or revoked if any false information is supplied toward securing the permit, any unauthorized changes are made to the site/any unauthorized changes are made in the installation of the system. Improvement Permit with plat valid without expiration ☐ Improvement Permit with site plan valid for sixty months ☑ Authorization to Construct is valid for a period equal to that of Improvement Permit – not to exceed sixty months.

Signed: Cheng Cong Yang date 4/20/07 Installed by: Scott Greene

Improvement Permit by: STEVE HEDRICK date 4-20-07 Operation Permit by: J. Hedrick, R.S. date 4 Dec. 07

Authorization to Construct by: STEVE HEDRICK date 4-20-07 Existing System Inspection by: date

HEALTH DEPT. COPY: WHITE OWNER COPY (FINAL): YELLOW OWNER COPY (INITIAL): PINK