IREDELL COUNTY HEALTH DEPARTMENT

Statesville Phone TR 3-7271 Mooresville Phone No. 664-5281

PERMIT TO INSTALL SEPTIC TANK

Permit No. 477 Permit Date 6-4 1973

Owner John Hege (Bill Cochran Bldr) Address Statesville NC

Installed By Sam Ostwalt Address Troutman N.C.

Location of Property I-40-W. to old Mountain Rd. T.R. Pass Ser. Sta. T.R. into Londerosa Estates House on L.


Tank		Capacity		Length of Lines		Fixtures	
Block	( )	1000	( )	225'	( )	No. of Baths	(3)
Precast	(✓)	1250	(✓)	250'	( )	Dishwasher	(✓)
		1500	( )	Other 272		Garbage Grdr.	(✓)
		Other				Other	

NOTIFY HEALTH DEPARTMENT AT LEAST EIGHT HOURS BEFORE TANK IS TO BE INSPECTED.

Final Inspection 6-4 1973 Approved (✓) Disapproved ( )

Remarks Well 100' away

4 lines due to lay of lot.

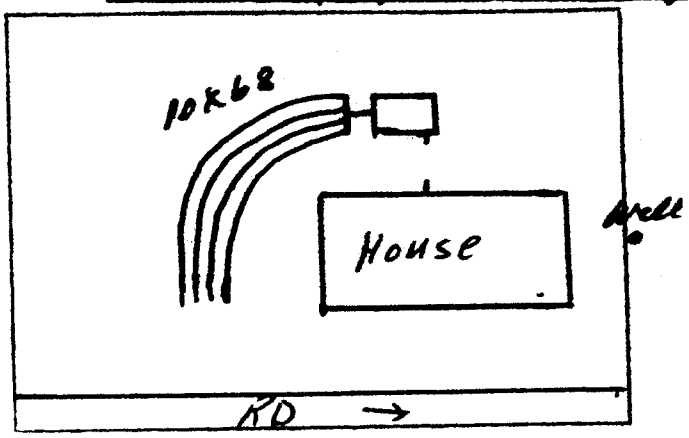

Sketch of Installation

E. A. Stevenson

Sanitarian