IREDELL COUNTY HEALTH DEPARTMENT

STATESVILLE 704-878-5305 MOORESVILLE 704-664-5281

92469

IMPROVEMENT PERMIT / CERTIFICATE OF COMPLETION / OPERATION PERMIT / EXISTING SYSTEM INSPECTION

PROPERTY DESCRIPTION NO. 22469 DATE 11-20-95 TAX MAP NO. 8M-9-A-2 Watershed: ☐ Yes ☑ No

OWNER OR CONTRACTOR ERNEST H. RUNGE PHONE: Business Home 872-6645

ADDRESS 374 LONG ISLAND ROAD STATESVILLE, NC 28677

LOCATION I-40 W, TR OLD MTN RD, TR CONIFER DR, TL PINE BARK COURT, 2ND LOT ON LEFT

SUBDIVISION PINE RIDGE BLOCK / SECTION LOT 2 LOT AREA 0.637 ACRE SITE CLASS. PS DESIGN FLOW 360 L.T.A.R. 0.30 GPA/FT²

Septic Tank: 1000 Gallons; STB Date 9-18-96
Pump Tank: Gallons; PT Date
Pump Make: Model Serial No.
Nitrification Field: No Fields 1 Square Feet 1200 Linear Feet 400
No Lines 4 Trench Width 36" Max Trench Bottom Depth 18 - 36" Gravel Depth 12"

☑ New System ☐ Repair System Type: I, II, III, IV, V, VI
System Description: CONVENTIONAL GRAVITY
Repair System Description: CHAMBERED PUMP
Maintenance Agreement Required: ☐ Yes ☑ No

☐ House/Mod. Home ☑ Mobile Home ☐ Business ☐ Other
No. Bedrooms 3 No. Bathrooms 2 No. Employees


☐ Slab ☑ Crawl Space ☐ Basement w/plumbing ☐ Basement wo/plumbing

Water Supply: ☐ Individual ☐ Community ☑ Public


Comments: ① CONSTRUCT SUBSURFACE INTERCEPT DRAIN AS SHOWN ABOVE SYSTEM & REPAIR AREA ② USE THREE FLOW DIVIDER TEES TO ACHIEVE EQUAL DISTRIBUTION INTO FOUR LINES ③ INSTALL LINES ON CONTOUR AS SHOWN

Comments: Approved ✓ septic System
Intercept Drain Not Done

INITIAL SITE SKETCH

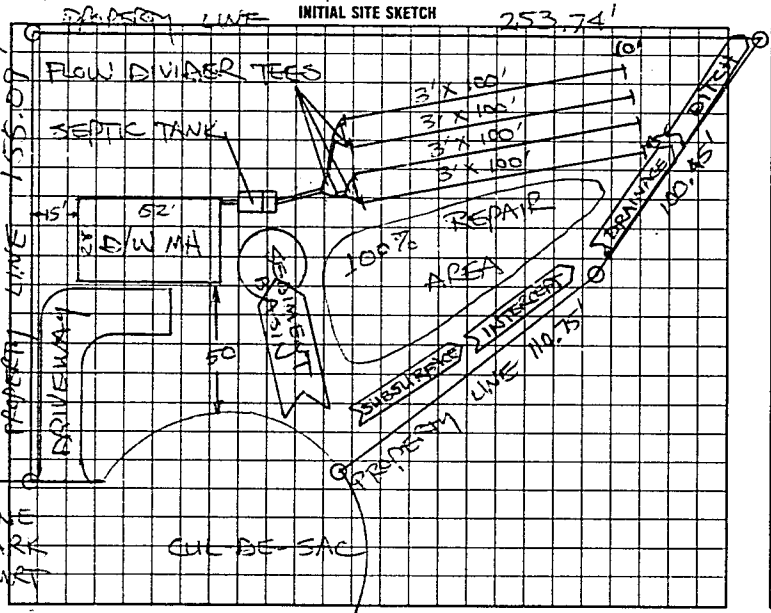

AS BUILT SKETCH

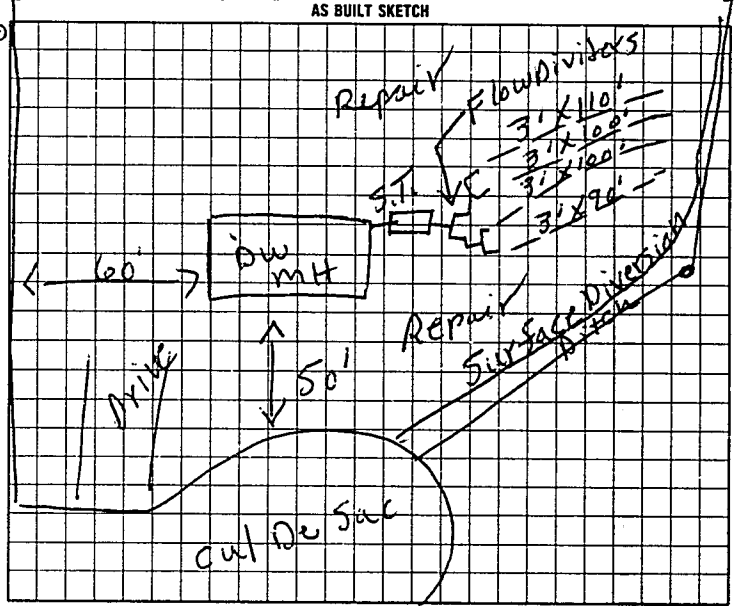

I understand that this permit can be suspended or revoked if any false information is supplied toward securing the permit/any unauthorized changes are made to the site/any unauthorized changes are made in the installation of the system.

AUTHORIZATION TO CONSTRUCT IS VALID FOR (5) YEARS FROM DATE OF ISSUANCE. IMPROVEMENT PERMIT HAS NO EXPIRATION DATE.

Signed

Improvement Permit by: STEVE HENDRICK date 11-20-95

AUTHORIZATION TO CONSTRUCT

~~Existing System Inspection~~ by: STEVE HENDRICK date 4-10-96

Installed by: G & M Enterprises

~~Certificate of Completion by:~~ date

Operation Permit by: P. C. Moore date 11-7-96

HEALTH DEPT COPY: WHITE INSPECTION COPY (FINAL): GREEN OWNER COPY (FINAL): YELLOW INSPECTION COPY (INITIAL): PINK OWNER COPY (INITIAL): GOLD

00209